

S
627.83
N7BDM
2004

BAIR DAM

MANUAL FOR OPERATION AND MAINTENANCE

STATE DOCUMENTS COLLECTION

1153 6 2004

MONTANA STATE LIBRARY
3015 E. 6th AVE
HELENA, MT 59601

**State Water Projects Bureau
Water Resources Division
Department of Natural Resources and Conservation
1424 9th Avenue
P.O. Box 201601
Helena, MT 59620-1601**

**Initial Publication May 1995
Revised February 2004**

MONTANA STATE LIBRARY



3 0864 0014 8217 6

BAIR DAM

MANUAL FOR OPERATION AND MAINTENANCE

**State Water Projects Bureau
Water Resources Division
Department of Natural Resources and Conservation
1424 9th Avenue
P.O. Box 201601
Helena, MT 59620-1601**

**Initial Publication May 1995
Revised February 2004**



Digitized by the Internet Archive
in 2015

<https://archive.org/details/bairdammanualfor2004mont>

TABLE OF CONTENTS

	<u>PAGE</u>
PROJECT DESCRIPTION.....	1
Overview.....	1
Embankment.....	1
Outlet Works	2
Spillway.....	2
Drains	3
Figure 1: Location Map	4
Figure 2: Project Area Map	5
Figure 3: Dam General Layout Map.....	6
Figure 4: Monitoring Wells Map.....	7
STATISTICAL INFORMATION	9
OPERATING PROCEDURES	13
Dam Operator.....	13
Method and Schedule of Operation	14
Gate Operation	15
Spillway.....	15
Safe Drawdown.....	16
Storage Determination	16
Inflow and Outflow Monitoring.....	17
Weather Monitoring	17
Interaction with Other Dams	18
Emergency.....	18
INSPECTION AND MONITORING.....	19
Structural Features Inspection	19
Riprap Inspection	20
Drains	20
Monitoring Wells.....	21
Seepage	22
Seepage Monitoring	22
Spillway Wall Monitoring	22
MAINTENANCE	23
Routine Maintenance.....	23
Annual Maintenance.....	24
Record Keeping	25
REFERENCES.....	27

TABLE OF CONTENTS (continued)

	<u>PAGE</u>
APPENDICES	29
A. RATING CURVES AND TABLES	A1
Table 1. SLOPE STORAGE TABLE -SOUTH SHORE.....	A2
Table 2. TOTAL STORAGE TABLE	A7
Table 3. SPILLWAY RATING CURVE AND TABLE.....	A10
B. INSPECTION REPORT FORM	B1
C. DISTRIBUTION LIST	C1
D. MONITORING WELL LOGS	D1
E. TEST PIT LOGS	E1
F. SPILLWAY EXTENDED WARRANTY	F1
G. PROJECT DRAWINGS.....	G1

PROJECT DESCRIPTION

OVERVIEW

Bair Dam is located in Meagher County approximately three-quarters of a mile northwest of the town of Checkerboard (Figure 1). The reservoir (and dam) is located on and fed by the North Fork Musselshell River (Figure 2). Figure 3 provides a general layout of the dam, spillway and outlet works. Figure 4 shows the location of the monitoring wells.

The dam is owned by the Montana Department of Natural Resources and Conservation (DNRC) and is managed by the State Water Projects Bureau (SWPB) of the DNRC. The Upper Musselshell Water Users Association (herein called the "Association") operates and maintains the dam.

With the reservoir at the spillway crest, the active storage is 7,300 acre-feet. Water from the reservoir is primarily used for irrigation water supply. The reservoir is also used for water-based recreation.

EMBANKMENT

The zoned earthfill dam was initially completed in 1939. During the 2001-2002 rehabilitation, the dam was raised about 4 feet and the crest widened 3 feet. Also a berm was added to about mid-height on the downstream face of the dam made up of waste material from flattening the left abutment slope above the spillway and removing a portion of the left abutment slope above the spillway to correct a landslide. Bair Dam is 106 feet high, 580 feet long and has a crest width of 30 feet.

OUTLET WORKS

The dam's outlet works consists of: a concrete intake structure; a 54-inch reinforced concrete arch conduit; a 48-inch diameter butterfly (operating gate) valve; a 48-inch diameter slide (emergency gate) gate; a control tower; and an outlet structure. The control tower contains the gate operators for the two gates. The maximum capacity of the outlet works is 650 cubic feet per second (cfs).

During the 2001-2002 rehabilitation, the gatehouse on the dam crest and the outlet structure were replaced.

SPILLWAY

The spillway located in the left abutment is an uncontrolled, rectangular, concrete chute. The spillway has a circular arc ogee-shaped crest section at elevation 5,325 feet. The crest length (arc length) is 65 feet. The chute width at the crest is 56 feet and then transitions over 35 feet length to a 40 feet wide chute. The stilling basin at the bottom of the spillway is a hydraulic jump under low to moderate flows. The design capacity of the spillway is 10,500 cfs (design flood pool elevation 5,337.6 feet).

During the 2001-2002 rehabilitation, the original spillway was replaced with a new larger spillway to meet dam safety standards. Additionally the left abutment slope was cutback and flattened to eliminate rock and talus from accumulating in the spillway. The new spillway has a capacity of 14,000 cfs with the reservoir pool at the dam crest (elevation 5,340.0 feet).

In June 2002, DNRC personnel observed several tension cracks in the overburden soils on the hillside east directly above the spillway excavation. Some of the crack displacements were up to 12 inches both horizontally and vertically. To reduce the chance of a landslide, approximately 25,000 cubic yards of soil and rock

were removed. In the spring 2003, additional cracks, up to 6 inched horizontally, occurred but movement stopped during the summer. It is hoped and presumed this is settlement from the landslide stabilizations work done in 2002.

DRAINS

The drawings for the dam (circa 1938) show a toe drain that begins in each abutment and is joined at the toe and exits to the left of the outlet. The drain outlet could not be observed since the area where the drain was supposed to exit is covered with several feet of loose rock. A backhoe was used in an attempt to locate the toe drainpipe in 1995, but the pipe was not found. However, water does exit from this area into the outlet channel. A V-notch weir was installed in 1997 so the discharge could be measured.

During the 2001-2002 rehabilitation, another attempt using an excavator was made to find the toe drain. The clay tile drain was not found. Instead of a tie-in to the existing drain, a stand-alone drain system was installed. The stand-alone drain consists of a manhole with two 12-inch diameter perforated PVC pipes, each 10-foot long, entering the manhole, and one 20 foot 12-inch diameter PVC pipe exiting the manhole to the outlet channel. The V-notch weir added in 1997 was removed. A drain pipe was also added to the right of the outlet structure. This drain is a 12-inch diameter perforated PVC pipe which is 20 feet long. Refer to drawing D1 in Appendix G.

Also a drainage system was added beneath the new concrete spillway with six outlets which day-light to the right of the spillway and two outlets which day-light through the flip-bucket wing walls. Refer to drawing SC5 in Appendix G.

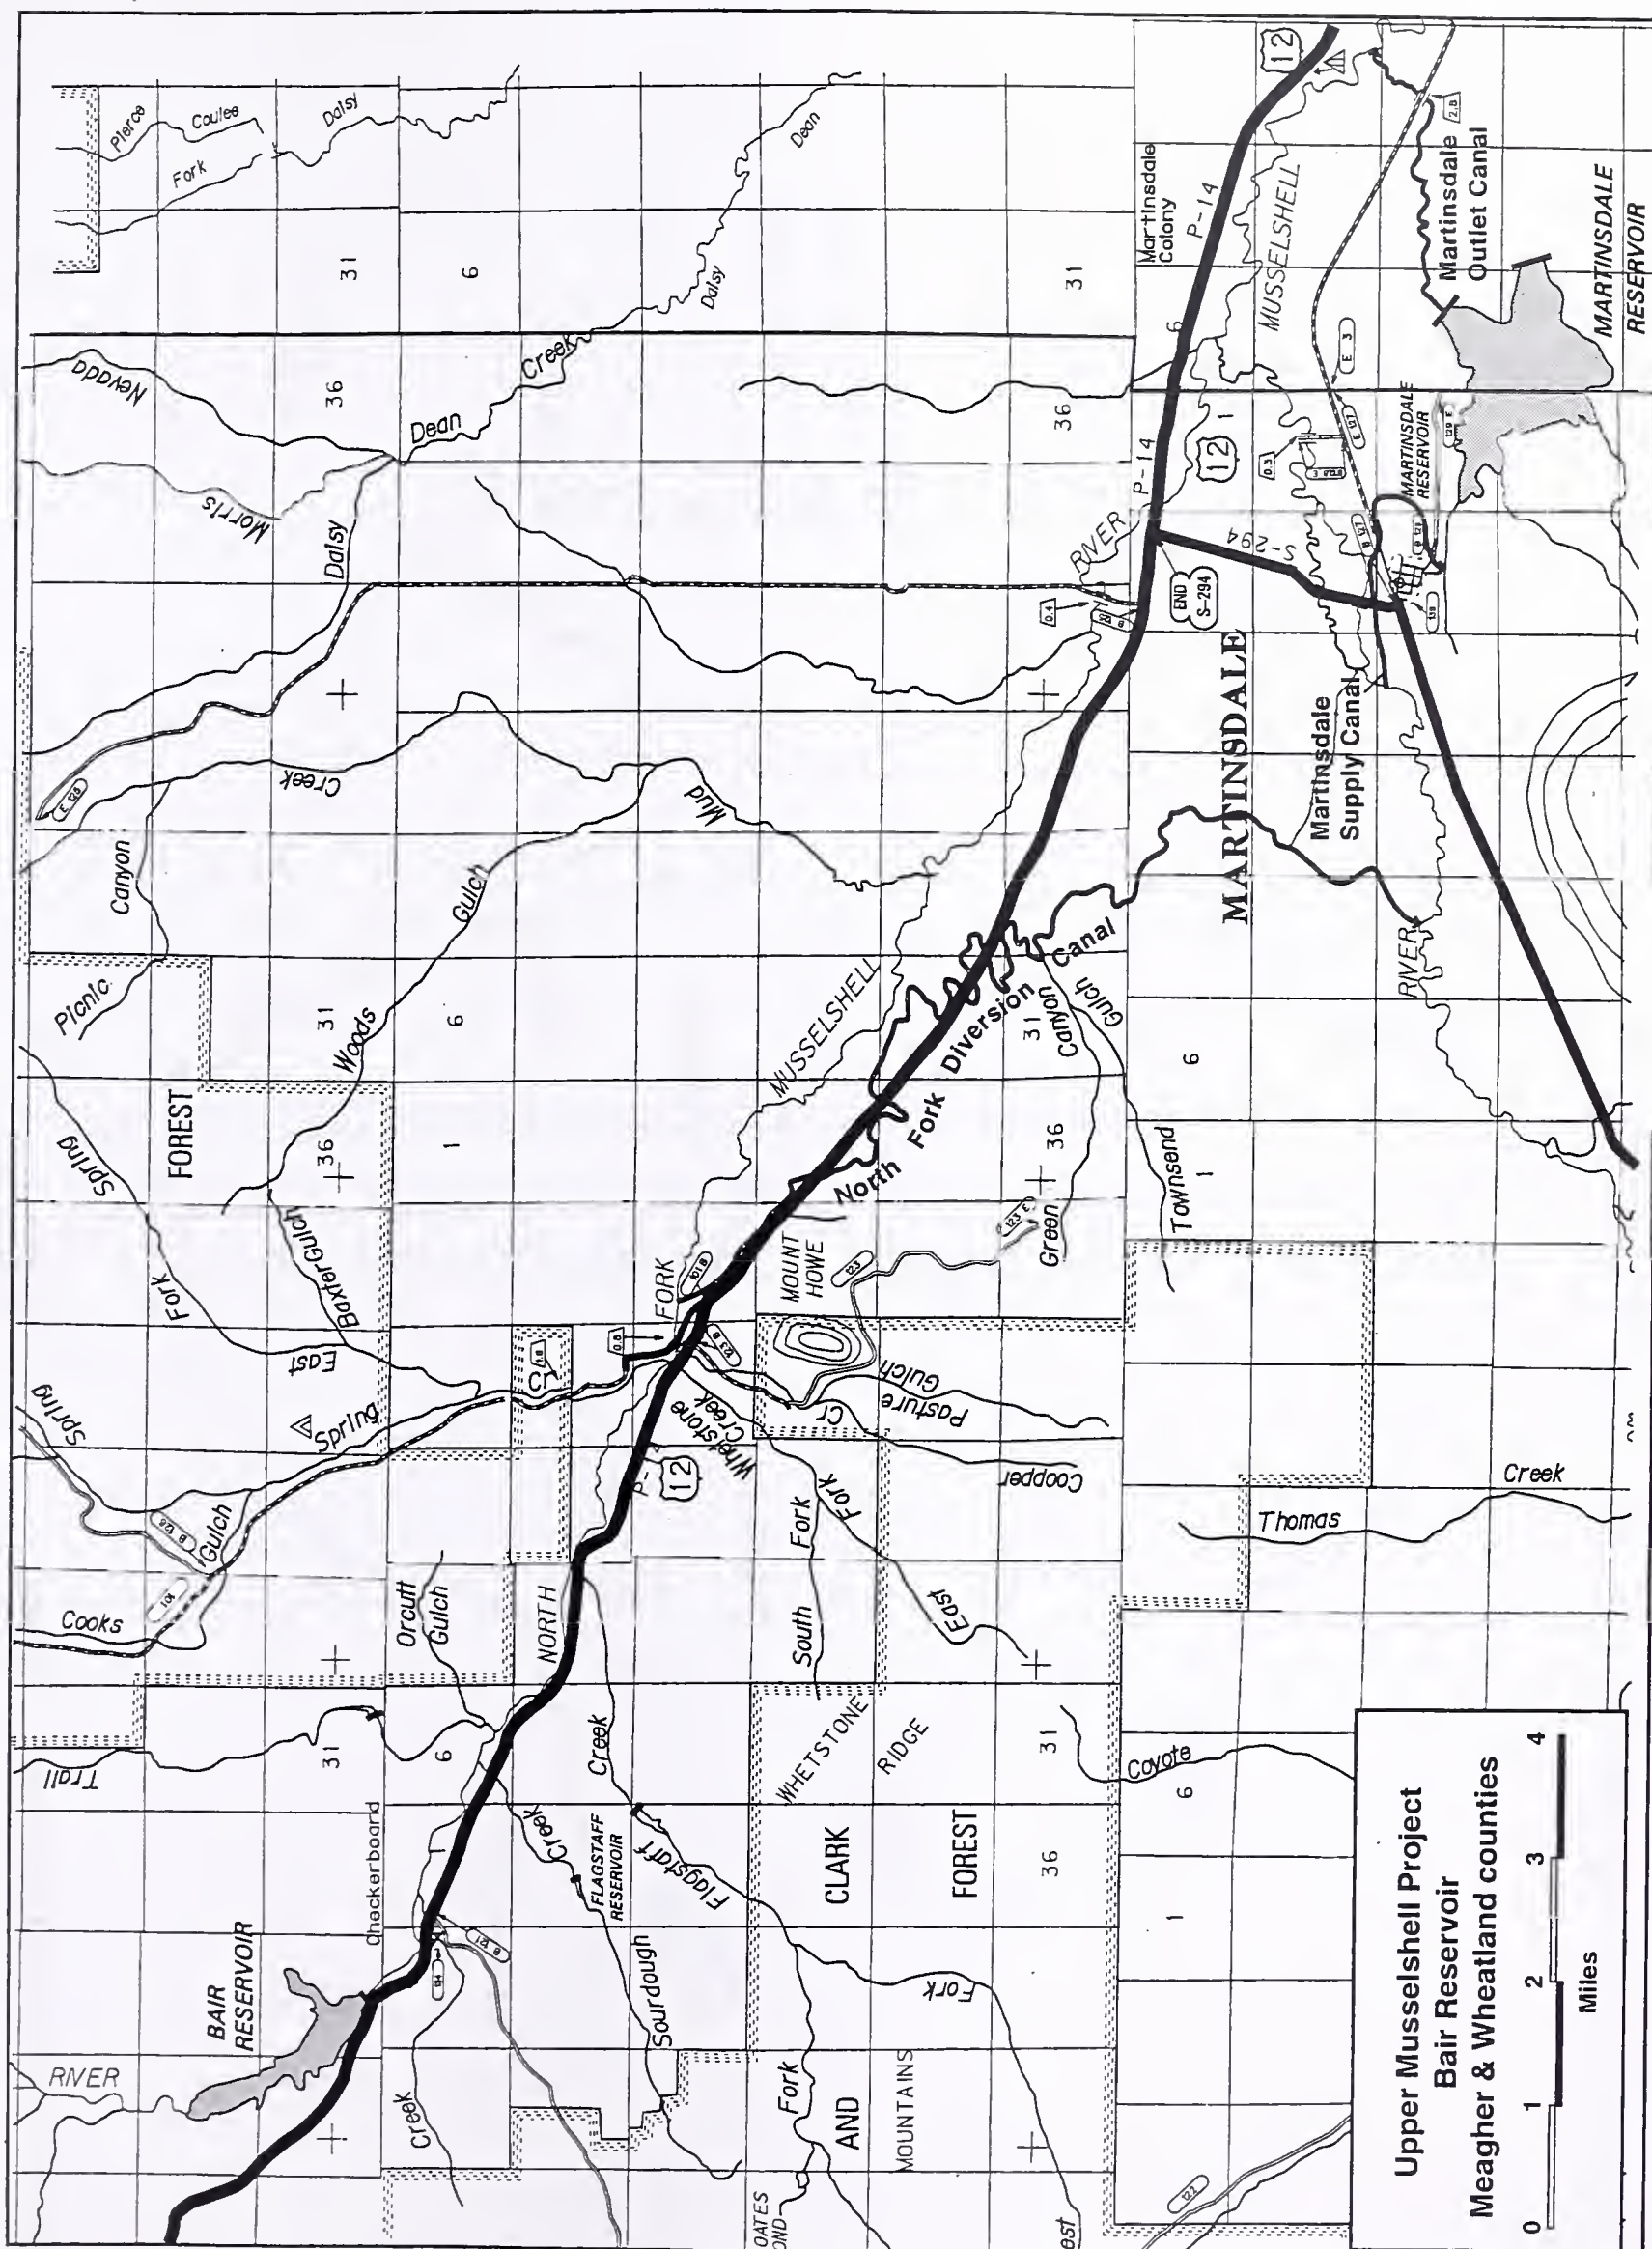


Figure 2. Bair Dam Project Map

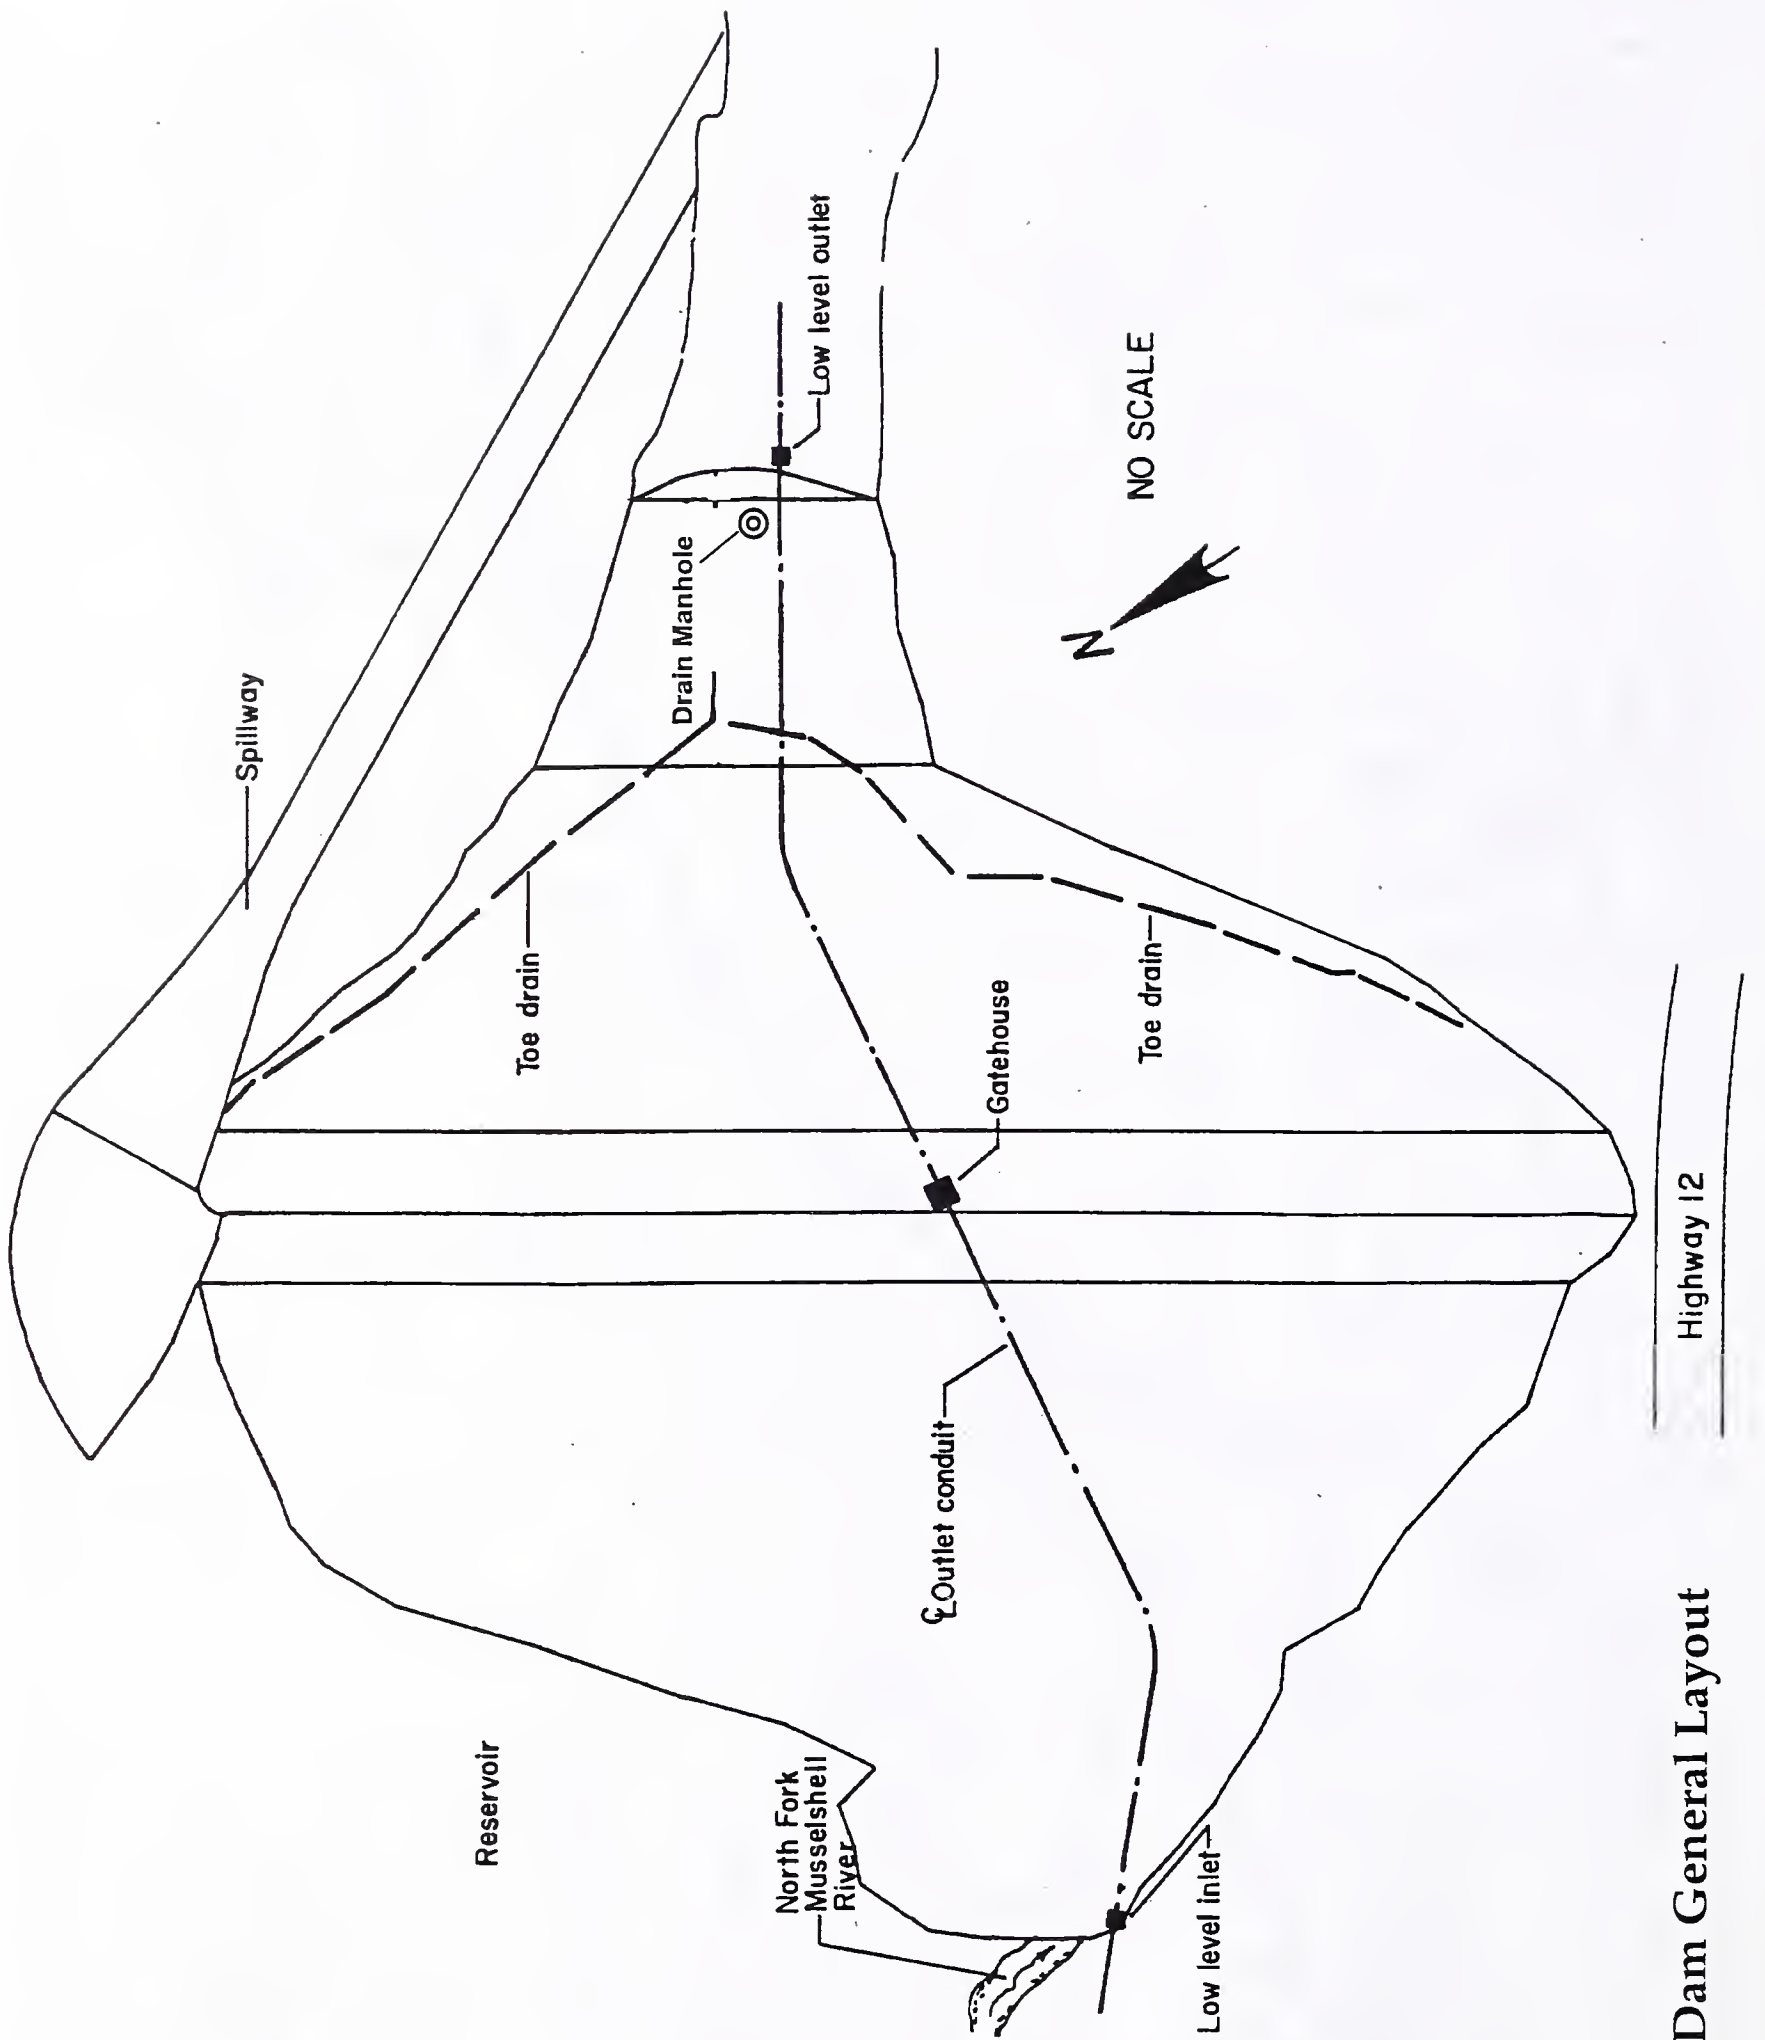


Figure 3. Bair Dam General Layout

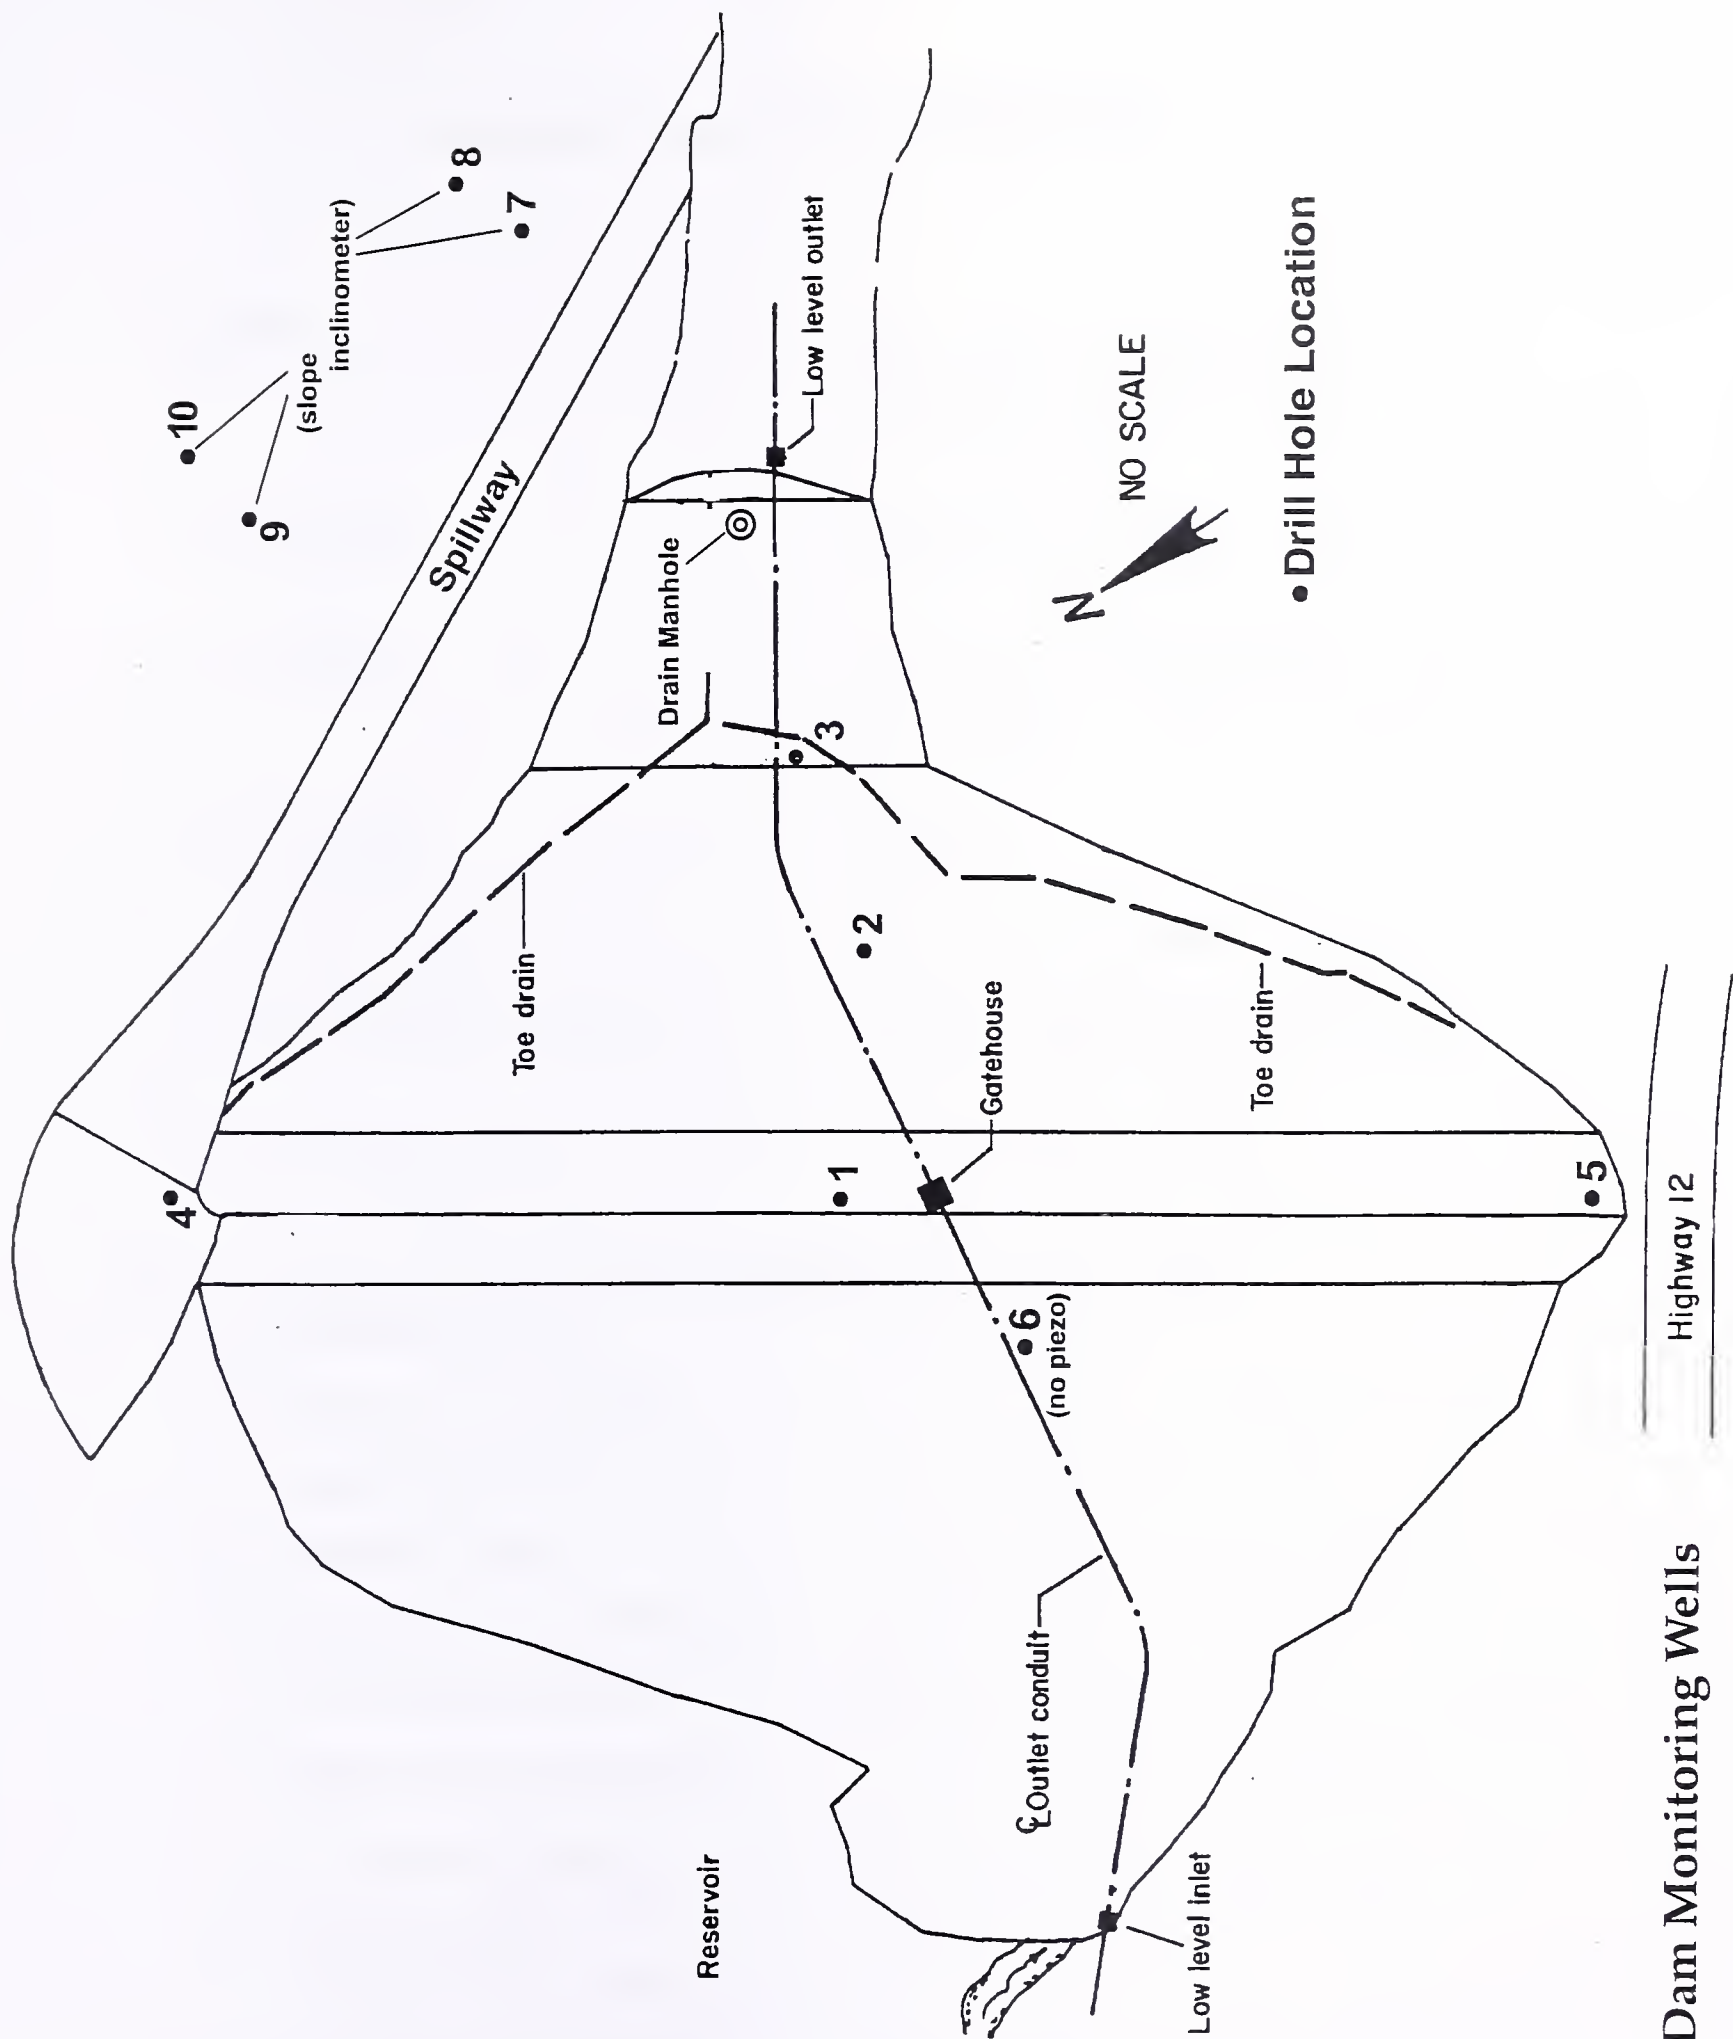


Figure 4. Bair Dam Monitoring Wells Location

Highway 12

STATISTICAL INFORMATION

1. General

a. Owner	Montana Department of Natural Resources and Conservation
b. Operator	Upper Musselshell Water Users Association
c. Location	Sections 27, 34 and 35 Township 10 North, Range 9 East MPM
d. Latitude	46.58°
Longitude	110.56°
e. County-State	Meagher-Montana
f. Watershed Location	North Fork Musselshell River, Missouri River Basin
g. Drainage Area	51.72 square miles

2. Principal Elevations (feet above mean sea level)

a. Gatehouse Floor	5,340.56 feet
b. Minimum Dam Crest	5,340.0 feet
c. Normal Full Pool	5,325.0 feet
d. Spillway Crest	5,325.0 feet
e. Downstream Toe Berm	5,390.0 feet
f. Top of Intake Tower	5,258.36 feet
g. Intake Invert (surveyed)	5,247.36 feet
h. Top Outlet Headwall	5,243.22 feet
i. Conduit Invert (inside intake tower)	5,236.21 feet
j. Outlet Structure Invert	± 5,234.5 feet

3. Reservoir

- | | |
|--|-----------------------------|
| a. Length of Pool
(approximate) | 1.9 miles |
| b. Maximum Reservoir
Level of Record | 5,325.5 feet (May 16, 1979) |
| c. Surface Area
(at normal full pool) | 279.54 acres |
| d. Freeboard
(at normal full pool) | 15 feet |
| e. Freeboard
(at design flood) | 2.4 feet |

4. Storage

- | | |
|--|------------------|
| a. Maximum Storage
(at dam crest) | 12,475 acre-feet |
| b. Active Storage
(at spillway crest) | 7,300 acre feet |
| c. Maximum Surcharge
(from spillway to dam crest) | 5,175 acre-feet |

5. Hydrology

- | | |
|--|------------------------|
| a. Inflow Design Flood
(Probable Maximum Flood) | 22,608 cfs peak inflow |
| b. Dam Safety Rules Flood | 8,207 cfs peak inflow |
| c. 100-Year Flood | 495 cfs |
| d. 500-Year Flood | 1,322 cfs |
| e. Spillway Loss of Life
(at design flood) | 100 persons |
| f. Min. Required Loss of Life | 38.25 persons |

6. Embankment (Dam)

- | | |
|---------------------|------------------------------|
| a. Type | Zoned Earthfill and Rockfill |
| b. Hydraulic Height | 106 feet |
| c. Crest Length | 580 feet |
| d. Crest Width | 30 feet |

- | | |
|---|------------|
| e. Downstream Slope | 1v on 2.0h |
| f. Upstream Slope
(above elevation 5,325 feet) | 1v on 2.0h |
| g. Upstream Slope
(below elevation 5,325 feet) | 1v on 3.0h |

7. Spillway

- | | |
|--|---|
| a. Location | Left abutment |
| b. Type | Uncontrolled ogee, circular arc |
| c. Design Head | 12.6 feet |
| d. Crest Length (arc length) | 65 feet |
| e. Chute Width at Crest | 56 feet |
| f. Transition Length | 35 feet |
| g. Chute Width below Transition | 40 feet |
| h. Length | 450 feet |
| i. Stilling Basin Type | Hydraulic jump under low/moderate flows |
| j. Maximum Capacity
(at design flood) | 10,500 cfs |

8. Outlet Works

- | | |
|--|---|
| a. Size | 54-inch reinforced concrete arch pipe |
| b. Length | 550 feet |
| c. Control | 48-inch diameter butterfly valve (operating gate) and a 48-inch diameter slidegate (emergency gate) with manual operators |
| d. Capacity
(pool at elev. 5336 feet) | 650 cfs |
| e. Trashrack | Yes
3" x ½" x 5'6" bars @ 5.5" centers |

OPERATING PROCEDURES

The Upper Musselshell Water Users Association operates Bair Reservoir to provide an adequate supply of irrigation water to meet contracts with water users without exceeding safe storage or flow levels.

DAM OPERATOR

The responsibility for the daily operation of the dam and reservoir rests with the association and its dam operator. The dam operator is generally authorized to operate the reservoir to meet the association's goal of providing an adequate supply of contracted irrigation water without exceeding safe storage or flow levels. The dam operator's specific responsibilities are to:

1. Operate the mechanical features of the outlet works.
2. Coordinate filling of the reservoir and the release of water.
3. Notify the SWPB of unusual occurrences, such as impending floods or excessive seepage.
4. Perform various maintenance tasks.
5. Monitor weather conditions.
6. Monitor seepage.

Typically, the out-going dam operator, water users association, and the SWPB train a new dam operator. The dam operator's training focuses on the mechanical operation of the gates, measurement of the storage level, measurement of the rate of water release, and record keeping.

The dam operator normally is available to observe the dam and perform operating functions daily during the irrigation season. During the non-irrigation season, one of the officers or directors observe and regulate the dam on a monthly basis. Communication among the dam operator, the association, and the SWPB usually

takes place by telephone. Although not routinely available, radio communication may be established during emergencies or unusual occurrences, so the dam operator can speak directly with county authorities and communicate indirectly with the SWPB (see Bair Dam Emergency Plan).

METHOD AND SCHEDULE OF OPERATION

Depending on snowpack, runoff patterns, and carryover storage, filling the reservoir usually starts in April or May. The goal is to have the reservoir full before the main runoff has receded to a flow where all inflow must be allowed downstream to satisfy senior water rights.

The date irrigation releases begin varies from year to year. The water delivery contracts provide that water will be available to the users between the dates of May 1 and September 30. However, if water is available, water may be released outside the contract dates. Late April is the earliest month during which irrigation releases have begun. During typical years, releases begin around June 1 and end by mid-September. The actual dates that releases begin and end depend on each year's climatological and hydrological conditions.

Maximum Winter Storage: The maximum reservoir elevation for winter storage is 5,315 feet with 4,913 acre-feet of storage. This winter maximum helps prevent damage to the riprap and embankment from wind-driven waves and ice.

Minimum Winter Storage: The minimum reservoir elevation for winter storage is 5,275 feet with 687 acre-feet of storage. This winter minimum helps prevent ice damage to the inlet structure for the outlet works.

Minimum Outlet Discharge: To help maintain the fishery in the North Fork Musselshell River, the minimum outflow to be maintained at the dam outlet during the winter low flow period should be approximately equal to the inflow. In a normal year, the average outflow during the non-irrigation period is 4 to 6 cfs. Cutting outflows to below the minimum will be allowed only as needed to accommodate necessary dam safety inspections, maintenance, drought conditions, or other emergency purposes.

Fish, Wildlife and Parks (FW&P) would prefer a minimum flow of 10 to 16 cfs be maintained at the dam outlet to help maintain the fishery in the Musselshell River.

GATE OPERATION

The outlet gates are manually operated with a hand crank. The outlet works are intended to be used for controlling the release of irrigation water and not for providing emergency relief. With the reservoir pool at the dam crest, the maximum capacity of the outlet works is 650 cfs.

The maximum gate opening for the operating gate is 2 feet of stem travel. Openings in excess of this amount may damage the gate, gate frame, gate stem or the gate pedestal. The 2 feet of operation is measured on the exposed portion of the gate stem between the top of the pedestal and the bottom of the stop nut.

The emergency gate stem travel is approximately 4 feet as this is a 48-inch slide gate moved from fully open to fully closed, and vise-versa.

SPILLWAY

The design capacity of the spillway is 10,500 cfs. At this flow, there would be 12.6 feet head over the spillway crest with 2.4 feet of freeboard on the dam crest. With the reservoir pool at the

dam crest (elevation 5,340.0 feet), the spillway has a capacity of 14,000 cfs. A spillway rating table is shown in Appendix A.

During the rehabilitation of the spillway in 2002, placement of the ogee crest concrete by the contractor did not meet line and grade tolerance requirements. Limited repairs were made, and the contractor agreed to an extended warranty until June 13, 2013. A copy of the warranty is in Appendix F.

SAFE DRAWDOWN

A geotechnical investigation and analysis of the Bair Dam were completed by HKM Engineering Inc. and the results were published in an October 1, 2000 geotechnical investigation report. The stability of Bair Dam has been thoroughly investigated showing that the rapid drawdown of the upstream face of the dam embankment will not cause a stability problem during rapid drawdown conditions. The drawdown factors indicate that the dam embankment face will remain stable by a considerable amount.

STORAGE DETERMINATION

Storage volume of the reservoir and elevation of the reservoir surface are determined by taking a slope measurement. Measure in feet from the 0+00 pin to the water surface. The 0+00 pin is located on the south side of the reservoir approximately 900 feet east of the picnic shelter by the boat ramp. A white fiberglass fencepost marks the location of the 0+00 pin. Once the slope distance measurement is determined, the elevation of the reservoir surface and the storage can be found using the Slope Distance-Elevation-Storage Table in Appendix A.

INFLOW AND OUTFLOW MONITORING

Current inflows to the reservoir can be found using the SWPB gaging station. The gage is located on the right bank of North Fork Musselshell River approximately 2.5 miles upstream of the dam.

Current outflows from the reservoir can be found using the SWPB gaging station which is located on the right bank of North Fork Musselshell River approximately 0.5 miles downstream of the dam.

Both gages are maintained and operated by SWPB staff. The gages are typically operational from May 1 to September 30 of each year.

WEATHER MONITORING

The dam operator monitors weather conditions through local weather forecasts and the National Weather Service.

If severe flooding is anticipated, the NWS Great Falls Office (**406-453-2081 or 406-453-4561**) should be contacted for information about the storm, such as the estimated storm intensity and duration, runoff duration (above base flow), and total flood volume of the storm in the Musselshell River drainage.

SNOTEL Sites: Current snow water equivalent and total precipitation can be monitored at two SNOTEL sites located above the reservoir – Spur Park and Daisy Peak. The information for these two sites can be accessed under the Smith, Judith And Musselshell River Basins portion of the following USDA internet site:

<ftp://ftp.wcc.nrcs.usda.gov/data/snow/update/mt.txt>

Additional information about historical snowpack, precipitation, maps and graphs can be accessed at the following internet site:

<http://www.mt.nrcs.usda.gov/swcs/snow/snow.html>

INTERACTION WITH OTHER DAMS

With the exception of the Fort Peck Dam, the only dams located downstream from Bair Dam are irrigation diversion dams. The safety of these dams are not affected by the operation of Bair Reservoir during either normal or emergency operations. There are no reservoirs of a large size upstream of Bair Dam. Therefore, interaction with other dams is not a concern during the normal operation of Bair Dam.

EMERGENCY

If it appears that the Bair Dam is about to breach, or during emergency operations, the dam operator will initiate the **Bair Dam Emergency Action Plan**.

INSPECTION AND MONITORING

The SWPB will inspect the dam annually. Appendix B includes an example of a SWPB inspection report form. In addition to annual inspections, SWPB personnel will inspect the dam and reservoir during and after heavy runoff and severe rainstorms and windstorms, during high storage periods, and after an earthquake. The water surface through the embankment is monitored by using monitoring wells.

STRUCTURAL FEATURES INSPECTION

Structural features include the control tower, spillway, and outlet works (see Figure 3). The SWPB will inspect these structures annually as part of its inspection program. Items to be checked or noted include, but are not limited to:

1. Outlet Works
 - a. Any differential settlement or movement resulting in cracking of the conduit
 - b. Erosion of the seals or concrete by cavitation immediately downstream of the gates
 - c. Major seepage of water into the conduit
 - d. Major deterioration of exposed concrete due to freeze/thaw cycles or sulfate reactions
 - e. Operation of all gates through a full cycle
 - f. Jet pump, for obstructions and operation
 - g. Free, unobstructed operation of the air vent
 - h. Corrosion of any metal
 - i. Proper lubrication of the gate pedestals
2. Gatehouse—Any damage or vandalism
3. Spillway
 - a. Deterioration of concrete
 - b. Separation or movement of joints

- c. Erosion of the spillway chute, backfill behind the walls, or stilling basin
- d. Blockage of the approach or exit channel
- 4. Embankment
 - a. Erosion gullies in the dam
 - b. Damage from burrowing animals or vegetation
 - c. Displacement or loss of rip-rap protection
 - d. Displacement of fill, sink holes, slumps etc.
 - e. Any seepage

RIPRAP INSPECTION

The riprap on the upstream face of the dam should be at least 30 inches thick. Immediately after the occurrence of high water, the riprap will be inspected and additional riprap added if needed.

DRAINS

During the 2001-2002 rehabilitation, a stand-alone drain system was installed to the left of the outlet structure. The drain consists of a manhole with two 12-inch diameter perforated PVC pipes, each 10-foot long, entering the manhole, and one 20 foot 12-inch diameter PVC pipe exiting the manhole into the outlet channel. A drain pipe was also added to the right of the outlet structure. This drain is a 12-inch diameter perforated PVC pipe which is 20 feet long and exits through the right outlet wingwall into the outlet channel. Refer to drawing D1 in Appendix G.

Also a drainage system was added beneath the new concrete spillway with six outlets which day-light to the right of the spillway and two outlets which day-light through the flip-bucket wing walls. The drainage system has three cleanouts; two located on the north side and one on the south side of the spillway. Refer to drawing SC5 in Appendix G.

MONITORING WELLS

Five drill holes in the dam embankment and one slope inclinometer in the left abutment above the spillway were installed in 1999. In 2002, three additional slope inclinometers were installed in the left abutment above the spillway. See Figure 4 for the location of the monitoring wells. Soil profiles of the drill holes and details as to how the wells were constructed are shown in Appendix D.

DH-1	1999	two standpipes dam crest - middle of dam
DH-2	1999	two standpipes downstream side of dam – middle of dam
DH-3	1999	two standpipes downstream side of dam – middle of dam
DH-4	1999	one standpipe upstream of spillway crest – right hand side
DH-5	1999	two standpipes dam crest – right abutment destroyed during 2002 rehabilitation redrilled in 2003
DH-7	1999	one standpipe – inclinometer tube left abutment above spillway
DH-8	2002	one standpipe – inclinometer tube left abutment above spillway
DH-9	2002	one standpipe – inclinometer tube left abutment above spillway
DH-10	2002	one standpipe – inclinometer tube left abutment above spillway

SEEPAGE

Prior to the 2001-2002 rehabilitation, seepage was observed exiting from around the right outlet tunnel wing wall at irregular intervals. This seepage was not measurable. During the rehabilitation, a drain was added to the right of the outlet structure and exits through the right outlet wingwall. The drain has been observed flowing, however the flow cannot be measured as the exit is slightly below the surface of the water in the stilling basin for the outlet.

SEEPAGE MONITORING

The monitoring wells, seepage areas, and drains at the dam are observed and monitored by the dam operator, DNRC Lewistown Regional Office, and SWPB during regular visits; and may be measured by the SWPB during annual inspections. The instruments are generally measured twice per month from May 1 to August 31, and once per month in March, April, September, and October. Measurements may be taken during the winter months (November, December, January, February) depending on weather conditions. The monitoring data is maintained by the SWPB in Helena.

The four slope inclinometer drill holes are measured with the slope inclinometer three to four times per year. Over time the frequency of measurement for the slope inclinometer drill holes may decrease.

SPILLWAY WALL MONITORING

Monuments have been drilled and epoxied into the top of the spillway walls to check for movement. Each monument is a 3/8" x 2½" stainless steel carriage bolt located 3 inches from the outer edge of the wall. There are six points on the north wall and six points on the south wall. Refer to drawing SS1 in Appendix G.

MAINTENANCE

The association is responsible for routine maintenance of the project. In addition, the SWPB may identify items that need maintenance or repair during the annual inspection.

ROUTINE MAINTENANCE

To protect the dam and keep it in good working order, the dam operator during regular visits to the dam will watch for and identify any potential maintenance requirements. As soon as a need is identified, the dam operator needs to schedule and perform the routine maintenance.

Items that may occasionally need attention include, but are not limited to:

1. *Lubrication and cleaning of the gate-operating mechanisms.*
2. *Debris or silt restricting the spillway inlet or the outlet works.* Accumulated debris that could affect the operation of these appurtenances will be removed at once, with all debris removed at least annually before the runoff season.
3. *Erosion gullies on embankment.* Development of erosion gullies will be checked immediately. Gullies will be filled, compacted, and seeded. Particular attention will be paid to the abutment contact areas and the downstream face.
4. *Rodent damage.* The rodents will be removed or destroyed, and any burrow holes should be filled immediately with compacted backfill.
5. *Upstream slope riprap.* The upstream face riprap normally will be observed annually, but may occasionally need repairs because of high water or wave action.
6. *Vegetative cover on downstream slopes.* Good vegetative cover will be maintained, but large brush and any trees will be removed.

7. *Noxious weeds.* Noxious weeds on and around the dam embankment and around the reservoir shall be sprayed at least on an annual basis.
8. *Cleaning spillway and outlet wall tops.* Spillway and outlet wall tops should be clear of any dirt, rocks, grass, brush, and any overhanging vegetation or trees.
9. *Repair of the spillway joints and sealing of cracks in the spillway.*

ANNUAL MAINTENANCE

The SWPB conducts annual inspections of the Bair Dam and Reservoir. During these inspections, any items requiring annual maintenance will be identified and recorded. Items that may need annual maintenance include the spillway, outlet works, gates, riprap, roads and gatehouse. Other routine items needing immediate attention, such as the need to remove trees or brush, will also be noted.

After the inspection, the SWPB sends the association a Dam Safety Inspection Report and a Maintenance Report. The reports identify items that need maintenance and provide a schedule of when the maintenance tasks need to be completed. The association is responsible for performing the maintenance items within the times specified.

The dam operator or association members may perform the maintenance tasks. However, major repairs will likely to be handled by a contractor. The SWPB may assist in contracting for repairs and may supervise the repair work.

RECORD KEEPING

The SWPB will maintain records, including photographs, of all inspections and maintenance requirements. These records will also include flow measurements and storage volumes. Anyone who wants to review these records may do so in the SWPB's office at the Department of Natural Resources and Conservation in Helena.

The dam operator will keep records of the reservoir elevation, seepage observation or measurements, and any unusual conditions. These records may be reviewed at the dam operator's house.

REFERENCES

U.S. Army Corps of Engineers. March 1981. Phase I Inspection Report; National Dam Safety Program; Missouri-Musselshell Basin, Bair Dam and Reservoir, Meagher County, (MT 6). Prepared for the State of Montana (DNRC) by Hoskins-Western-Sonderegger, Inc. under the U.S. Army Corps of Engineers' National Dam Safety Program.

Berg, Donald, Upper Musselshell Water Users Association President; July 13, 1994.

Telephone communications with Sterling Sundheim, Regional Office Civil Engineering Specialist, Water Resources Division, DNRC, Lewistown.

Parish, Lovell, Regional Geologist. 1998. Geotechnical Inspection of Bair Dam - Meagher County, Montana. Prepared for the State of Montana (DNRC) by the Bureau of Reclamation, Great Plains Office, Billings Regional Office, Montana.

HKM Engineering Inc. October 1, 2000. Bair Dam Rehabilitation Feasibility Study Report. Prepared for the Montana Department of Natural Resources and Conservation, State Water Projects Bureau, Helena, Montana by HKM Engineering Inc. Billings, Montana.

HKM Engineering Inc. October 1, 2000. Bair Dam Rehabilitation Feasibility Study Report -- Appendices B-E.

HKM Engineering Inc. October 1, 2000. Bair Dam Rehabilitation Feasibility Study Report -- Appendices G -- Geotechnical Investigation and Analysis.

HKM Engineering Inc. October 1, 2000. Bair Dam Rehabilitation Feasibility Study Report -- Appendices H -- Hydrologic Investigation and Analysis.

HKM Engineering Inc. August, 2001. Project Manual for Bair Dam Rehabilitation Project – Phase I Meagher County, Montana.

REFERENCES (continued)

HKM Engineering Inc. February, 2002. Project Manual for Bair Dam Rehabilitation Project – Phase II Meagher County, Montana.

HKM Engineering Inc. March, 2002. Bair Dam Rehabilitation Project – Phase I and Phase II Design Report (draft).

HKM Engineering Inc. October, 2003. Bair Dam Rehabilitation Construction Report (draft).

APPENDICES

APPENDIX A
RATING CURVES AND TABLES

**TABLE 1. SLOPE-ELEVATION-STORAGE TABLE
BAIR RESERVOIR SOUTH SHORE SLOPE**

Pins installed September 6, 2000.

Elevations established with a level on September 14, 2000.

The 0+00 pin located 911 feet east of the HKM CP 2, which is near the picnic shelter by the the boat ramp. The line begins just east of a road gap in the shoreline willows and 55 feet downslope of a steel guard post at a boundary pin and 50 feet from an aluminum cap (CP Z) on the same line.

A white fiberglass post marks the 0+00 pin.

There is no 0+50 pin.

Volume from HKM total storage table of 2000.

DISTANCE	ELEVATION	STORAGE		DISTANCE	ELEVATION	STORAGE
0+00 CAP	5325.55	7,455		36	5320.60	6,151
1	5325.32	7,390		37	5320.54	6,137
2	5325.09	7,325		38	5320.48	6,122
3	5324.86	7,261		39	5320.42	6,108
4	5324.63	7,197		40	5320.35	6,091
SPILLWAY	5324.63	7,197		41	5320.29	6,077
5	5324.41	7,137		42	5320.23	6,062
6	5324.22	7,085		43	5320.16	6,045
7	5324.04	7,036		44	5320.10	6,031
8	5323.86	6,987		45	5320.02	6,012
9	5323.68	6,939		46	5319.93	5,990
10	5323.50	6,890		47	5319.84	5,969
11	5323.32	6,842		48	5319.76	5,950
12	5323.14	6,795		49	5319.67	5,929
13	5322.96	6,746		50	5319.59	5,910
14	5322.77	6,698		51	5319.50	5,889
15	5322.59	6,651		52	5319.42	5,870
16	5322.41	6,605		53	5319.33	5,849
17	5322.29	6,576		54	5319.24	5,828
18	5322.18	6,546		55	5319.16	5,810
19	5322.06	6,515		56	5319.07	5,789
20	5321.94	6,484		57	5318.99	5,771
21	5321.82	6,454		58	5318.90	5,750
22	5321.70	6,424		59	5318.82	5,732
23	5321.58	6,393		60	5318.73	5,711
24	5321.47	6,366		61	5318.64	5,690
25	5321.35	6,336		62	5318.56	5,672
26	5321.23	6,306		63	5318.48	5,654
27	5321.17	6,292		64	5318.41	5,638
28	5321.10	6,274		65	5318.33	5,620
29	5321.04	6,259		66	5318.26	5,604
30	5320.98	6,244		67	5318.18	5,587
31	5320.92	6,230		68	5318.11	5,571
32	5320.85	6,212		69	5318.03	5,553
33	5320.79	6,198		70	5317.96	5,537
34	5320.73	6,183		71	5317.88	5,520
35	5320.67	6,168		72	5317.81	5,504
DISTANCE	ELEVATION	STORAGE		DISTANCE	ELEVATION	STORAGE

TABLE 1. SLOPE-ELEVATION-STORAGE TABLE (continued)
BAIR RESERVOIR SOUTH SHORE SLOPE

DISTANCE	ELEVATION	STORAGE		DISTANCE	ELEVATION	STORAGE
73	5317.73	5,487		120	5312.40	4,412
74	5317.66	5,471		121	5312.27	4,388
75	5317.58	5,454		122	5312.15	4,366
76	5317.51	5,438		123	5312.02	4,343
77	5317.43	5,421		124	5311.90	4,321
78	5317.36	5,405		125	5311.77	4,297
79	5317.28	5,388		126	5311.65	4,275
80	5317.21	5,373		127	5311.53	4,253
81	5317.13	5,356		128	5311.40	4,230
82	5317.01	5,330		129	5311.28	4,208
83	5316.88	5,302		130	5311.15	4,186
84	5316.75	5,274		131	5311.03	4,164
85	5316.63	5,248		132	5310.90	4,141
86	5316.50	5,221		133	5310.78	4,120
87	5316.37	5,194		134	5310.66	4,099
88	5316.25	5,168		135	5310.53	4,076
89	5316.12	5,139		136	5310.41	4,056
90	5315.99	5,114		137	5310.31	4,038
91	5315.87	5,090		138	5310.21	4,021
92	5315.74	5,062		139	5310.11	4,004
93	5315.61	5,036		140	5310.02	3,988
94	5315.49	5,012		141	5309.92	3,971
95	5315.36	4,985		142	5309.82	3,953
96	5315.23	4,959		143	5309.72	3,936
97	5315.11	4,935		144	5309.63	3,921
98	5314.98	4,909		145	5309.53	3,904
99	5314.85	4,883		146	5309.43	3,888
100	5314.73	4,859		147	5309.33	3,871
1+00 CAP	5314.68	4,849		148	5309.24	3,856
101	5314.61	4,835		149	5309.14	3,839
102	5314.50	4,813		150	5309.04	3,822
103	5314.38	4,790		1+50 CAP	5308.99	3,814
104	5314.26	4,766		151	5308.99	3,814
105	5314.15	4,745		152	5308.93	3,804
106	5314.03	4,722		153	5308.87	3,794
107	5313.91	4,698		154	5308.82	3,786
108	5313.80	4,670		155	5308.76	3,776
109	5313.68	4,654		156	5308.71	3,768
110	5313.57	4,632		157	5308.65	3,758
111	5313.45	4,610		158	5308.59	3,748
112	5313.33	4,587		159	5308.54	3,740
113	5313.22	4,566		160	5308.48	3,730
114	5313.10	4,543		161	5308.42	3,720
115	5312.98	4,520		162	5308.37	3,712
116	5312.87	4,500		163	5308.31	3,703
117	5312.75	4,478		164	5308.25	3,693
118	5312.64	4,457		165	5308.20	3,685
119	5312.52	4,433		166	5308.14	3,675
DISTANCE	ELEVATION	STORAGE		DISTANCE	ELEVATION	STORAGE

TABLE 1. SLOPE-ELEVATION-STORAGE TABLE (continued)
BAIR RESERVOIR SOUTH SHORE SLOPE

DISTANCE	ELEVATION	STORAGE	DISTANCE	ELEVATION	STORAGE
167	5308.08	3,665	214	5307.52	3,576
168	5308.03	3,657	215	5307.52	3,576
169	5307.97	3,647	216	5307.52	3,576
170	5307.91	3,638	217	5307.50	3,570
171	5307.85	3,628	218	5307.47	3,568
172	5307.82	3,623	219	5307.44	3,563
173	5307.79	3,618	220	5307.42	3,560
174	5307.76	3,614	221	5307.39	3,555
175	5307.73	3,609	222	5307.36	3,551
176	5307.70	3,604	223	5307.34	3,547
177	5307.67	3,601	224	5307.31	3,543
178	5307.64	3,594	225	5307.28	3,538
179	5307.61	3,590	226	5307.26	3,545
180	5307.58	3,585	227	5307.23	3,538
181	5307.57	3,583	228	5307.16	3,519
182	5307.55	3,581	229	5307.08	3,507
183	5307.54	3,579	230	5307.01	3,496
184	5307.53	3,578	231	5306.94	3,485
185	5307.51	3,575	232	5306.87	3,474
186	5307.50	3,573	233	5306.79	3,462
187	5307.48	3,570	234	5306.72	3,451
188	5307.47	3,568	235	5306.65	3,440
189	5307.46	3,567	236	5306.58	3,429
190	5307.44	3,563	237	5306.50	3,417
191	5307.43	3,562	238	5306.44	3,408
192	5307.43	3,562	239	5306.37	3,398
193	5307.42	3,560	240	5306.30	3,387
194	5307.41	3,559	241	5306.24	3,377
195	5307.40	3,557	242	5306.17	3,367
196	5307.39	3,555	243	5306.10	3,356
197	5307.38	3,554	244	5306.04	3,347
198	5307.37	3,552	245	5305.94	3,332
199	5307.36	3,551	246	5305.83	3,315
200	5307.35	3,549	247	5305.73	3,301
2+00 CAP	5307.35	3,549	248	5305.63	3,286
201	5307.37	3,552	249	5305.53	3,272
202	5307.39	3,555	250	5305.43	3,256
203	5307.41	3,559	2+50 CAP	5305.39	3,251
204	5307.44	3,563	251	5305.34	3,243
205	5307.46	3,567	252	5305.25	3,230
206	5307.48	3,570	253	5305.17	3,219
207	5307.50	3,570	254	5305.08	3,205
208	5307.52	3,576	255	5305.00	3,193
209	5307.52	3,576	256	5304.91	3,180
210	5307.52	3,576	257	5304.80	3,165
211	5307.52	3,576	258	5304.69	3,149
212	5307.52	3,576	259	5304.58	3,133
213	5307.52	3,576	260	5304.47	3,118
DISTANCE	ELEVATION	STORAGE	DISTANCE	ELEVATION	STORAGE

TABLE 1. SLOPE-ELEVATION-STORAGE TABLE (continued)
BAIR RESERVOIR SOUTH SHORE SLOPE

DISTANCE	ELEVATION	STORAGE		DISTANCE	ELEVATION	STORAGE
261	5304.36	3,101		308	5296.26	2,132
262	5304.25	3,086		309	5295.90	2,096
263	5304.14	3,071		310	5295.54	2,066
264	5304.03	3,055		311	5295.17	2,024
265	5303.92	3,040		312	5294.81	1,990
266	5303.81	3,024		313	5294.57	1,968
267	5303.72	3,013		314	5294.32	1,943
268	5303.63	3,000		315	5294.07	1,921
269	5303.53	2,986		316	5293.83	1,900
270	5303.44	2,974		317	5293.58	1,870
271	5303.35	2,962		318	5293.28	1,850
272	5303.25	2,948		319	5292.97	1,823
273	5303.16	2,936		320	5292.67	1,797
274	5303.07	2,924		321	5292.37	1,771
275	5302.97	2,911		322	5292.06	1,745
276	5302.86	2,896		323	5291.76	1,720
277	5302.74	2,880		324	5291.49	1,698
278	5302.63	2,866		325	5291.22	1,676
279	5302.51	2,850		326	5290.96	1,655
280	5302.40	2,836		327	5290.34	1,606
281	5302.28	2,820		328	5289.73	1,560
282	5302.16	2,805		329	5289.12	1,514
283	5302.05	2,790		330	5288.94	1,501
284	5301.93	2,775		331	5288.75	1,488
285	5301.82	2,761		332	5288.57	1,474
286	5301.67	2,742		333	5288.04	1,436
287	5301.52	2,723		334	5287.51	1,399
288	5301.37	2,704		335	5287.02	1,364
289	5301.22	2,686		336	5286.52	1,330
290	5301.06	2,666		337	5286.02	1,297
291	5300.91	2,647		338	5285.67	1,274
292	5300.76	2,629		339	5285.31	1,251
293	5300.55	2,604		340	5284.95	1,228
294	5300.35	2,580		341	5284.48	1,198
295	5300.14	2,555		342	5284.01	1,169
296	5299.93	2,531		343	5283.73	1,151
297	5299.72	2,506		344	5283.45	1,134
298	5299.51	2,482		345	5283.18	1,118
299	5299.31	2,459		346	5282.81	1,095
300	5299.10	2,435		347	5282.45	1,074
3+00 CAP	5299.05	2,430		348	5282.09	1,054
301	5298.75	2,396		349	5281.72	1,031
302	5298.40	2,357		3+50 CAP	5281.71	1,030
303	5298.05	2,318		350	5281.36	1,011
304	5297.70	2,281		351	5280.92	986
305	5297.35	2,244		352	5280.52	964
306	5296.98	2,205		353	5280.12	942
307	5296.62	2,168		354	5279.73	921
DISTANCE	ELEVATION	STORAGE		DISTANCE	ELEVATION	STORAGE

TABLE 1. SLOPE-ELEVATION-STORAGE TABLE (continued)
BAIR RESERVOIR SOUTH SHORE SLOPE

[illegible]

TABLE 2. TOTAL STORAGE IN ACRE-FEET**BAIR RESERVOIR**

Elevation	0.0	0.1	0.2	0.3	0.4	0.5	0.6	0.7	0.8	0.9
5241	0.00	0.00	0.00	0.00	0.00	0.01	0.01	0.02	0.03	0.04
5242	0.06	0.08	0.10	0.13	0.16	0.20	0.25	0.30	0.35	0.41
5243	0.5	0.6	0.6	0.7	0.8	0.9	1.1	1.2	1.3	1.5
5244	1.6	1.8	2.0	2.2	2.4	2.6	2.8	3.0	3.3	3.6
5245	3.8	4.1	4.4	4.8	5.1	5.5	5.8	6.2	6.6	7.1
5246	7.5	8.0	8.4	8.9	9.5	10	11	11	12	12
5247	13	14	14	15	16	16	17	18	19	20
5248	20	21	22	23	23	24	25	26	27	28
5249	28	29	30	31	32	33	33	34	35	36
5250	37	38	39	40	41	42	43	44	45	46
5251	47	48	49	50	51	52	53	54	55	56
5252	57	58	59	60	61	63	64	65	66	67
5253	68	69	71	72	73	74	76	77	78	79
5254	81	82	83	85	86	87	89	90	91	93
5255	94	95	97	98	100	101	103	104	106	107
5256	109	110	112	113	115	117	118	120	122	123
5257	125	127	129	130	132	134	136	138	139	141
5258	143	145	147	149	151	153	155	157	159	161
5259	163	165	167	170	172	174	176	178	181	183
5260	185	187	190	192	194	197	199	202	204	206
5261	209	211	214	216	218	221	223	226	228	231
5262	233	236	239	241	244	246	249	252	254	257
5263	259	262	265	267	270	273	276	278	281	284
5264	287	289	292	295	298	301	304	307	309	312
5265	315	318	321	324	327	330	333	336	339	342
5266	345	348	351	355	358	361	364	367	370	374
5267	377	380	383	387	390	393	397	400	403	407
5268	410	414	417	420	424	427	431	434	438	441
5269	445	449	452	456	459	463	467	470	474	478
5270	482	485	489	493	497	501	504	508	512	516
5271	520	524	528	532	535	539	543	547	551	555
5272	559	563	568	572	576	580	584	588	592	596
5273	600	605	609	613	617	622	626	630	634	639
5274	643	647	652	656	661	665	669	674	678	683
5275	687	692	696	701	705	710	714	719	724	728

TABLE 2. TOTAL STORAGE IN ACRE-FEET (continued)**BAIR RESERVOIR**

Elevation	0.0	0.1	0.2	0.3	0.4	0.5	0.6	0.7	0.8	0.9
5276	733	738	742	747	752	757	761	766	771	776
5277	781	785	790	795	800	805	810	815	820	825
5278	830	835	840	845	851	856	861	866	871	876
5279	882	887	892	897	903	908	914	919	924	930
5280	935	941	946	952	957	963	968	974	979	985
5281	991	996	1,002	1,008	1,013	1,019	1,025	1,030	1,036	1,042
5282	1,048	1,054	1,059	1,065	1,071	1,077	1,083	1,089	1,095	1,101
5283	1,107	1,113	1,119	1,125	1,131	1,137	1,143	1,149	1,155	1,162
5284	1,168	1,174	1,180	1,187	1,193	1,199	1,205	1,212	1,218	1,224
5285	1,231	1,237	1,244	1,250	1,256	1,263	1,269	1,276	1,283	1,289
5286	1,296	1,302	1,309	1,316	1,322	1,329	1,336	1,343	1,350	1,356
5287	1,363	1,370	1,377	1,384	1,391	1,398	1,405	1,412	1,419	1,426
5288	1,433	1,440	1,447	1,455	1,462	1,469	1,476	1,484	1,491	1,498
5289	1,506	1,513	1,520	1,528	1,535	1,543	1,550	1,558	1,565	1,573
5290	1,580	1,588	1,596	1,603	1,611	1,619	1,627	1,635	1,643	1,650
5291	1,658	1,666	1,674	1,683	1,691	1,699	1,707	1,715	1,724	1,732
5292	1,740	1,749	1,757	1,765	1,774	1,782	1,791	1,800	1,808	1,817
5293	1,826	1,834	1,843	1,852	1,861	1,870	1,879	1,888	1,897	1,906
5294	1,915	1,924	1,933	1,943	1,952	1,961	1,971	1,980	1,989	1,999
5295	2,008	2,018	2,027	2,037	2,047	2,057	2,066	2,076	2,086	2,096
5296	2,106	2,116	2,126	2,136	2,146	2,156	2,166	2,176	2,187	2,197
5297	2,207	2,218	2,228	2,239	2,249	2,260	2,270	2,281	2,292	2,303
5298	2,313	2,324	2,335	2,346	2,357	2,368	2,379	2,390	2,401	2,413
5299	2,424	2,435	2,446	2,458	2,469	2,481	2,492	2,504	2,515	2,527
5300	2,539	2,550	2,562	2,574	2,586	2,598	2,610	2,622	2,634	2,646
5301	2,659	2,671	2,683	2,696	2,708	2,721	2,733	2,746	2,758	2,771
5302	2,784	2,797	2,810	2,823	2,836	2,849	2,862	2,875	2,888	2,901
5303	2,915	2,928	2,942	2,955	2,969	2,982	2,996	3,010	3,023	3,037
5304	3,051	3,065	3,079	3,093	3,107	3,122	3,136	3,150	3,165	3,179
5305	3,193	3,208	3,223	3,237	3,252	3,267	3,282	3,296	3,311	3,326
5306	3,341	3,356	3,371	3,387	3,402	3,417	3,432	3,448	3,463	3,479
5307	3,494	3,510	3,525	3,541	3,557	3,573	3,588	3,604	3,620	3,636
5308	3,652	3,668	3,685	3,701	3,717	3,733	3,750	3,766	3,783	3,799
5309	3,816	3,832	3,849	3,866	3,883	3,899	3,916	3,933	3,950	3,967
5310	3,985	4,002	4,019	4,036	4,054	4,071	4,088	4,106	4,124	4,141

TABLE 2. TOTAL STORAGE IN ACRE-FEET (continued)**BAIR RESERVOIR**

Elevation	0.0	0.1	0.2	0.3	0.4	0.5	0.6	0.7	0.8	0.9
5311	4,159	4,177	4,194	4,212	4,230	4,248	4,266	4,284	4,302	4,321
5312	4,339	4,357	4,375	4,394	4,412	4,431	4,449	4,468	4,487	4,505
5313	4,524	4,543	4,562	4,581	4,600	4,619	4,638	4,658	4,677	4,696
5314	4,716	4,735	4,755	4,774	4,794	4,813	4,833	4,853	4,873	4,893
5315	4,913	4,933	4,953	4,973	4,993	5,014	5,034	5,054	5,075	5,096
5316	5,116	5,137	5,158	5,179	5,200	5,221	5,242	5,263	5,285	5,306
5317	5,328	5,349	5,371	5,392	5,414	5,436	5,458	5,480	5,502	5,524
5318	5,546	5,569	5,591	5,613	5,636	5,658	5,681	5,704	5,727	5,750
5319	5,773	5,796	5,819	5,842	5,865	5,889	5,912	5,936	5,959	5,983
5320	6,007	6,031	6,055	6,079	6,103	6,127	6,151	6,176	6,200	6,225
5321	6,249	6,274	6,299	6,323	6,348	6,373	6,398	6,424	6,449	6,474
5322	6,500	6,525	6,551	6,576	6,602	6,628	6,654	6,680	6,706	6,732
5323	6,758	6,784	6,811	6,837	6,864	6,890	6,917	6,944	6,971	6,998
5324	7,025	7,052	7,079	7,107	7,134	7,161	7,189	7,217	7,244	7,272
5325	7,300	7,328	7,356	7,384	7,413	7,441	7,469	7,498	7,526	7,555
5326	7,584	7,613	7,642	7,671	7,700	7,729	7,758	7,787	7,817	7,846
5327	7,876	7,906	7,935	7,965	7,995	8,025	8,055	8,086	8,116	8,146
5328	8,177	8,207	8,238	8,269	8,299	8,330	8,361	8,392	8,424	8,455
5329	8,486	8,518	8,549	8,581	8,612	8,644	8,676	8,708	8,740	8,772
5330	8,804	8,837	8,869	8,902	8,934	8,967	9,000	9,032	9,065	9,098
5331	9,131	9,165	9,198	9,231	9,265	9,298	9,332	9,365	9,399	9,433
5332	9,467	9,501	9,535	9,569	9,604	9,638	9,673	9,707	9,742	9,777
5333	9,811	9,846	9,881	9,917	9,952	9,987	10,022	10,058	10,093	10,129
5334	10,165	10,201	10,236	10,272	10,309	10,345	10,381	10,417	10,454	10,490
5335	10,527	10,564	10,600	10,637	10,674	10,711	10,749	10,786	10,823	10,861
5336	10,898	10,936	10,974	11,011	11,049	11,087	11,125	11,164	11,202	11,240
5337	11,279	11,317	11,356	11,394	11,433	11,472	11,511	11,550	11,589	11,629
5338	11,668	11,708	11,747	11,787	11,827	11,866	11,906	11,946	11,986	12,027
5339	12,067	12,107	12,148	12,188	12,229	12,270	12,311	12,352	12,393	12,434
5340	12,475	12,517	12,558	12,600	12,641	12,683	12,725	12,767	12,809	12,851
5341	12,893	12,935	12,977	13,020	13,062	13,105	13,148	13,190	13,233	13,276
5342	13,319	13,362	13,406	13,449	13,492	13,536	13,579	13,623	13,667	13,711
5343	13,755	13,799	13,843	13,887	13,931	13,976	14,020	14,065	14,110	14,154
5344	14,199	14,244	14,289	14,335	14,380	14,425	14,471	14,516	14,562	14,607
5345	14,653									

Note: Active storage table based upon surveys by HKM in 1999.

Spillway Crest Elevation 5,325.0 feet Storage 7,300 acre-feet


Dam Crest Elevation 5,340.0 feet Storage 12,475 acre-feet

TABLE 3. SPILLWAY DISCHARGE

BAIR RESERVOIR

Depth Over Crest (feet)	Elevation (feet)	Discharge (cfs)
0	5325.0	0
1.0	5326.0	191
2.0	5327.0	558
3.0	5328.0	1063
4.0	5329.0	1670
5.0	5330.0	2392
6.0	5331.0	3215
8.0	5333.0	5100
10.0	5335.0	7281
12.0	5337.0	9807
14.0	5339.0	12345
15.0	5340.0	13677

BAIR DAM SPILLWAY RATING CURVE

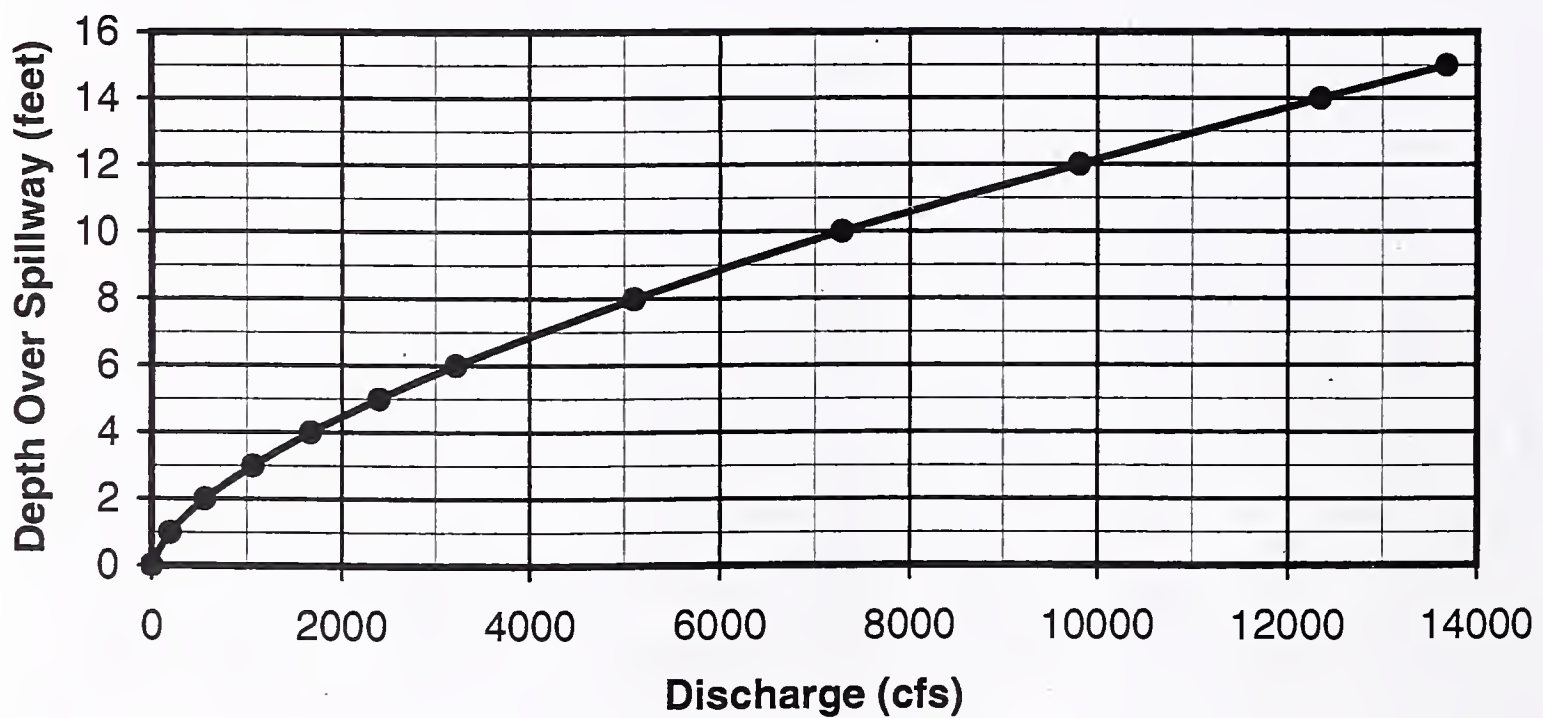

Note: Data from Bair Dam Rehabilitation Construction Report by HKM, dated 10/2003.

APPENDIX B

INSPECTION REPORT FORM

DEPARTMENT OF NATURAL RESOURCES AND CONSERVATION
DAM SAFETY INSPECTION REPORT

NAME OF DAM _____
DATE INSPECTED _____

INVENTORY NO. _____
HAZARD CATEGORY _____
TYPE OF DAM _____
YEAR BUILT _____

OWNER _____
OPERATOR _____
STREAM _____
DRAINAGE AREA _____

Reservoir Storage Status

	Water Surface Elevation (feet)	Storage (acre-feet)
At time of inspection	_____	_____
At spillway crest	_____	_____
At min. dam crest elevation	_____	_____

ITEM	YES	NO	REMARKS
------	-----	----	---------

1. EMBANKMENT

A. Crest -- Height= Length= Width=

(1) Any visual settlements?			
(2) Any misalignments?			
(3) Any cracking?			
(4) Any traffic damage?			
(5) Other?			

ITEM	YES	NO	REMARKS
------	-----	----	---------

1. EMBANKMENT (continued)

B. Upstream Face -- Slope=

(1) Any erosion?			
(2) Any longitudinal cracks?			
(3) Any transverse cracks?			
(4) Is riprap protection adequate?			
(5) Any stone deterioration?			
(6) Any visual settlement, slumps, sloughing, depressions or bulges?			
(7) Adequate grass cover?			
(8) Debris on the dam face?			
(9) Other?			

C. Downstream Face--Slope=

(1) Any erosion?			
(2) Any longitudinal cracks?			
(3) Any transverse cracks?			
(4) Any visual settlement, slumps, sloughing, depressions or bulges?			
(5) Is the toe drain dry?			
(6) Are the relief wells flowing?			
(7) Any boils at the toe?			
(8) Any seepage areas?			
(9) Any traffic or animal damage?			
(10) Any burrowing animals?			
(11) Adequate grass cover?			
(12) Other?			

D. Amount and Type of Vegetation on the Dam

--

ITEM	YES	NO	REMARKS
------	-----	----	---------

2. ABUTMENT CONTACTS

A) Any erosion?			
B) Any visual differential movement?			
C) Any cracks?			
D) Any seepage present?			
E) Other?			

3. OUTLET WORKS

A. Intake Structure -- Size=

(1) Any settlement?			
(2) Any tilting?			
(3) Do concrete surfaces show:			
a. Spalling?			
b. Cracking?			
c. Erosion?			
d. Exposed reinforcement?			
(4) Do joints show:			
a. Displacement or offset?			
b. Loss of joint material?			
c. Leakage?			
(5) Metal appurtenances:			
a. Any corrosion present?			
b. Any breakage present?			
(6) Trash rack?			
a. Condition?			
b. Anchor system secure?			
(7) Other?			

ITEM	YES	NO	REMARKS
------	-----	----	---------

3. OUTLET WORKS (continued)

B. Conduit -- Type =

Size =

(1) Do concrete surfaces show:			
a. Spalling?			
b. Cracking?			
c. Erosion?			
d. Exposed reinforcement?			
(2) Do joints show:			
a. Displacement or offset?			
b. Loss of joint material?			
c. Leakage?			
(3) Is the conduit metal?			
a. Any corrosion present?			
b. Protective coatings adequate?			
(4) Is the conduit misaligned?			
(5) Any calcium deposits?			
(6) Other?			

C. Gates and Tower

(1) Gates:			
a. Size: Operating:		Emergency:	
b. Type: Operating:		Emergency:	
(2) Controls operational?			
(3) Controls lubricated?			
(4) Operational problems?			
(5) Leakage around gates?			
(6) Condition of gate seals?			
(7) Any cavitation damage? If so, describe?			
(8) Describe air vent-size and condition.			

ITEM	YES	NO	REMARKS
------	-----	----	---------

3. OUTLET WORKS (continued)

C. Gates and Tower (continued)

(9) Is there a jet pump?			
a. Is it operational?			
b. Leakage?			
(10) Is the tower dry? ____ wet?			
(11) Any seepage in the tower?			
(12) Condition of the tower?			
(13) Any safety problems?			
(14) Ladder in good condition?			
(15) Condition of the gatehouse?			
(16) Emergency plan completed for the dam?			
a. Posted in the gatehouse?			
(17) Other?			

D. Stilling Basin

(1) Do concrete surfaces show:			
a. Spalling?			
b. Cracking?			
c. Erosion?			
d. Exposed reinforcement?			
(2) Do joints show:			
a. Displacement or offset?			
b. Loss of joint material?			
c. Leakage?			
(3) Do energy dissipaters show:			
a. Signs of deterioration?			
b. Are they covered with debris?			
(4) Other?			

ITEM	YES	NO	REMARKS
------	-----	----	---------

3. OUTLET WORKS (continued)

E. Downstream Channel

(1) Is the channel:			
a. Eroding or backcutting?			
b. Sloughing?			
c. Obstructed?			
(2) Is released water:			
a. Undercutting the outlet?			
b. Eroding the embankment?			
(3) Other?			

4. SPILLWAY

A. Description

(1) Location?			
(2) Type of Spillway?			
(3) Size of Spillway?			
(4) Spillway lining?			
(5) Is there a weir?			
(6) Is the spillway in good condition?			
(7) Any drains?			
a. Describe the condition of drains.			

B. Does spillway show:

(1) Any cracking concrete?			
(2) Any spalling concrete?			
(3) Any exposed reinforcement in the concrete?			
(4) Any erosion?			

ITEM	YES	NO	REMARKS
------	-----	----	---------

4. SPILLWAY (continued)

4. B. Does spillway show: (continued)

(5) Any slope sloughing?			
(6) Any obstructions?			
(7) Displacement or offset joints?			
(8) Loss of joint material?			
(9) Leakage at the joints?			
(10) Other?			

C. Do the energy dissipaters show:

(1) Signs of deterioration?			
(2) Any cracking?			
(3) Any spalling?			
(4) Any exposed reinforcement?			
(5) Are they covered with debris?			
(6) Other?			

D. Has release water:

(1) Eroded the embankment?			
(2) Undercut the outlet?			
(3) Eroded the downstream channel?			
(4) Other?			

E. Emergency Spillway

(1) Is there an emergency spillway?			(If YES, describe)

ITEM	YES	NO	REMARKS
------	-----	----	---------

5. RESERVOIR CONTROL

A) Recent upstream development?			
B) Recent downstream development?			
C) Slides in reservoir area?			
D) Change in reservoir operation?			
E) Large impoundment upstream?			
F) Any debris in the reservoir?			
G) Other?			

6. INSTRUMENTATION

A) List type(s) of instrumentation:			
B) In good condition?			
C) Read periodically?			
D) Is data available?			
E) Include all data gathered since last report.			

7. DOWNSTREAM CONDITION

A. Downstream Land Use.

--

This dam was inspected by:

Additional comments and recommendations.

APPENDIX C
DISTRIBUTION LIST

BAIR O&M DISTRIBUTION LIST

	<u>Number Of Copies</u>
1. State Water Projects Bureau Kevin Smith Rob Kingery Dirk Roberts (2) Bob Arrington Delores Eustice	6
2. DNRC Information Services Section	1
3. DNRC Lewistown Regional Office Scott Irwin Sterling Sundheim	2
4. DNRC Dam Safety	1
5. Water Users Eugene Taber -- President Kenneth Yerger -- Vice President Susan Moore -- Secretary/Treasurer	3
6. Dam Operator Dam Operator (Keith Hill) Gate House	2
7. State Library -- Attn: Roberta Gebhardt	4
8. Extra	2
=====	
TOTAL	21

APPENDIX D

MONITORING WELL LOGS

GEOTECHNICAL DRILLING PROGRAM RATIONALE
BAIR DAM

DRILL HOLE NO.	LOCATION	ANTICIPATED (ACTUAL) DEPTH (ft)	PIEZOMETER COMPLETION	PURPOSE(S)
99-1	Dam crest @ maximum section	120 (128.4)	(1) Embankment observation well (1) Foundation open-system piezometer	Determine embankment and foundation material properties, nature of foundation contact and phreatic surface location at maximum section for slope stability analysis.
99-2	Downstream face at two-thirds the dam height above the toe	90 (67.0)	(1) Embankment observation well (1) Foundation open system piezometer	(see above)
99-3	Downstream toe near 2:1/5:1 slope break	60 (52.5)	(1) Embankment observation well (1) Foundation open-system piezometer	(see above)
99-4	Left dam crest near spillway inlet	40 (51.0)	(1) Abutment open-system piezometer	Determine seepage and geologic conditions in the left abutment, determine the nature of the foundation contact and cutoff for the spillway and bedrock for excavation potential.
99-5	Right dam abutment	40 (92.6)	(1) Observation well (1) Abutment open-system piezometer	Determine seepage and geologic conditions in the right abutment.
99-6	Upstream face	85 (62.8)	None	Obtain data from upstream impervious zone; identify cut-off trench material and nature of contact with bedrock.
99-7	Slope above spillway	0 (98.6)	1.9" diameter inclinometer casing	Evaluate materials in slope above spillway and install inclinometer casing.

ROCK CLASSIFICATION DESCRIPTIONS

ROCK STRENGTH			
Class	Strength	Field Test	Approximate Range of Uniaxial Compressive Strength kg/cm ² (tons/ft ²)
I	Extremely Strong	Many blows with geologic hammer required to break intact specimen.	>2000
II	Very Strong	Hand held specimen breaks with hammer end of pick under more than one blow.	2000-1000
III	Strong	Cannot be scraped or peeled with knife, hand held specimen can be broken with single moderate blow with pick.	1000-500
IV	Moderately Strong	Can just be scraped or peeled with knife. Indentations 1mm to 3mm show in specimen with moderate blow with pick.	500-125
V	Moderately Weak to Weak	Material crumbles under moderate blow with sharp end of pick and can be peeled with a knife, but is too hard to hand trim for triaxial test specimen.	125-12

WEATHERING		
Grade	Symbol	Diagnostic Features
Fresh	F	No visible sign of decomposition or discoloration. Rings when struck by hammer.
Slightly Weathered	WS	Slight discoloration inwards from open fractures, otherwise similar to F.
Moderately Weathered	WM	Discoloration throughout. Weaker minerals such as feldspar decomposed. Strength somewhat less than fresh rock but cores cannot be broken by hand or scraped by knife. Texture preserved.
Highly Weathered	WH	Most minerals somewhat decomposed. Specimens can be broken by hand with effort or shaved with knife. Core stones present in rock mass. Texture becoming indistinct but fabric preserved.
Completely Weathered	WC	Minerals decomposed to soil but fabric and structure preserved (Saprolite). Specimens easily crumbled or penetrated.
Residual Soil	RS	Advanced state of decomposition resulting in plastic soils. Rock fabric and structure completely destroyed. Large volume change.

STRUCTURAL PARAMETERS		
Description for Structural Features: Bedding, Foliation, or Flow Banding	Spacing	Description for Joints, Faults or Other Fractures
Very Thickly (bedded, foliated, or banded)	More than 6 feet	Very Widely (fractured or jointed)
Thickly	2 - 6 feet	Widely
Medium	8 - 24 inches	Medium
Thinly	2½ - 8 inches	Closely
Very Thinly	¾ - 2½ inches	Very Closely
Description for Microstructural Features: Lamination, Foliation, or Cleavage		Description for Joints, Faults or Other Fractures
Intensely (laminated, foliated or cleaved)	¼ - ¾ inch	Extremely Close
Very Intensely	Less than ¼ inch	

RQD	
RQD (Rock Quality Designation)	Description of Rock Quality
0 - 25%	Very Poor
25 - 50%	Poor
50 - 75%	Fair
75 - 90%	Good
90 - 100%	Very Good

SOIL CLASSIFICATION/LEGEND

Unified Soil Classification System					
Criteria for Assigning Group Symbols and Names			Soil Classification Generalized Group Descriptions		
COARSE-GRAINED SOILS More than 50% retained on No. 200 sieve	GRAVELS More than 50% of coarse fraction retained on No. 4 sieve	CLEAN GRAVELS Less than 5% fines	GW	Well-graded gravels	
			GP	Poorly-graded gravels	
		GRAVELS w/ FINES More than 12% fines	GM	Gravel and silt mixtures	
			GC	Gravel & clay mixtures	
	SANDS 50% or more of coarse fraction passes No. 4 sieve	CLEAN SANDS Less than 5% fines	SW	Well-graded sands	
			SP	Poorly-graded sands	
		SANDS with FINES More than 12% fines	SM	Sand and silt mixtures	
			SC	Sand and clay mixtures	
FINE-GRAINED SOILS 50% or more passes the No. 200 sieve	SILTS & CLAYS Liquid limit less than 50	INORGANIC	CL	Low-plasticity clays	
			ML	Non-plastic and low-plasticity silts	
		ORGANIC	OL	Non-plastic and low-plasticity organic clays	
				Non-plastic and low-plasticity organic silts	
	SILTS & CLAYS Liquid limit Greater than 50	INORGANIC	CH	High-plasticity clays	
			MH	High-plasticity silts	
		ORGANIC	OH	High-plasticity organic clays	
				High-plasticity organic soils	
HIGHLY ORGANIC SOILS	Primarily organic matter, dark in color, and organic odor		PT	peat	

Component Definitions By Gradation	
Component	Size Range
Boulders	Greater than 12 in.
Cobbles	3 in. to 12 in.
Gravel	3 in. to No. 4 (4.75 mm)
Coarse gravel	3 in. to ¾ in.
Fine gravel	¾ in. to No. 4 (4.75 mm)
Sand	No. 4 (4.75 mm) to No. 200 (.075 mm)
Coarse sand	No. 4 (4.75 mm) to No. 10 (2.0 mm)
Medium sand	No. 10 (2.0 mm) to No. 40 (0.425 mm)
Fine sand	No. 40 (0.425 mm) to No. 200 (0.074 mm)
Silt and Clay	Smaller than No. 200 (0.075 mm)

Silt and Clay Descriptions	
Description	Typical Unified Designation
Silt	ML (non-plastic)
Clayey Silt	CL-ML (low plasticity)
Silty Clay, Lean Clay	CL
Clay, Fat Clay	CH
Plastic Silt	MH
Organic Soils	OL, OH, Pt

Relative Density or Consistency Utilizing Standard Penetration Test Values					
Cohesionless Soils ^(a)			Cohesive Soils ^(a)		
Density ^(a)	N blows/ft ^(a)	Relative Density (%)	Consistency	N blows/ft ^(a)	Undrained Shear Strength ^(a) (psf)
Very loose	0 to 4	0 - 15	Very soft	0 to 2	<250
Loose	4 to 10	15 - 35	Soft	2 to 4	250 - 500
Med. Dense	10 to 30	35 - 65	Med. Stiff	4 to 8	500 - 1000
Dense	30 to 50	65 - 85	Stiff	8 to 15	1000 - 2000
Very Dense	Over 50	>85	Very Stiff	15 to 30	2000 - 4000
			Hard	Over 30	>4000

- (a) Soils consisting of gravel, sand and silt, either separately or in combination, possessing no characteristics of plasticity and exhibiting drained behavior.
- (b) Soils possessing the characteristics of plasticity, and exhibiting undrained behavior.
- (c) Refer to text of ASTM D 1586 for a definition of N; in normally consolidated cohesionless soils relative density terms are based on N values corrected for overburden pressures.
- (d) Undrained shear strength = ½ unconfined compressive strength.

Groundwater Elevation	
	Water Elevation Noted During Drilling
	Water Elevation Recorded After Drilling Complete
	Water Elevation Recorded After Auger Removal

Soil Moisture	
Dry	Dry of the optimum moisture content.
Moist	Approximately at optimum moisture.
Very Moist To Wet	Wet of optimum to saturated.

Descriptive Terminology Denoting Components Proportions	
Descriptive Terms	Range of Proportion
Trace	0 - 5%
Little	5 - 12%
Some or Adjective ^(a)	12 - 30%
And	30 - 50%

(a) Use gravelly, sandy or silty as appropriate.

Samples	
	Split Spoon Sampler (2.0" OD)
	Ring Sampler (3.0" OD)
* Indicates increased blow counts due to sampler size.	
	Shelby Tube Sampler (3.0" OD)

Unless otherwise noted, drive samples advanced with 140 lb. Hammer with 30 in. drop.

Project No. 8M087.155

LOG OF BOREHOLE NO. DH99-1

Sheet 5 of 8

CLIENT
Montana Dept. of Natural Resources and Conservation

ARCHITECT/ENGINEER

HKM Engineering Inc.

SITE

Bair Reservoir, Montana

PROJECT

Bair Dam

(continued)

to compact, brown to brownish red

GRAPHIC LOG	DEPTH (FT.)	SAMPLES				TESTS				ADDITIONAL DATA/REMARKS	
		TYPE	BLOWS PER 6"	NUMBER	IN. RECOVERED IN. DRIVEN	POCKET PENE- TROMETER, TSF	N VALUE BLOWS/FOOT				
							PL	WC	LL		
			8 13 19	SS-16	16/18 89%	>4.3	●	I	□	62	Sample:SS-16 M.C.=12.4% USCS=GC Gravel=49% Sand=29% Fines=22% LL=62 PI=45
	85		5 10 13	SS-17	18/18 100%	2.25 3.0	●		□		Sample:SS-17 M.C.=17.8%
	90		8 15 15	SS-18	18/18 100%	2.5 3.25	●		□		Sample:SS-18 M.C.=17.7%
	95		10 15 16	SS-19	18/18 100%	2.5 3.25	●		□		Sample:SS-19 M.C.=18%
	100										

Continued Next Page

HKM
Engineering

 HKM Engineering Inc.
 222 North 32nd St.
 Billings, MT 59101
 Telephone: (406) 656-6399
 Fax: (406) 656-6398

STARTED	10/22/99	FINISHED	10/24/99
DRILL CO.	RB&G Eng.	DRILL RIG	CME-55
DRILLER	BH	ASST DRILLER	
LOGGED BY	JM	APPROVED BY	JTS

Project No. 8M087.155

LOG OF DRILLHOLE NO. DH99-1

Sheet 7 of 8

CLIENT
Montana Dept of Natural Resources and ConservationARCHITECT/ENGINEER
HKM Engineering Inc.SITE
Bair Reservoir, MontanaPROJECT
Bair Dam

(continued)

GRAPHIC LOG

DEPTH (FT.)

Core Run (#)

Recovery

R.Q.D. %

Weathering Index

Strength Index

Permeability (ft/yr)

Point Load Index

Unit Weight (pcf)

ADDITIONAL
DATA/
REMARKS

105.0

5231.9

105.2

5231.7

Metamorphosed Shale; olive, massive, fresh,
very strong, laminatedLithographic Limestone/Quartzite; gray, massive
except for fractures, slightly weathered, strong,
closely fractured, fracture staining/infiltrating of
white/olive calcite, some fractures healed with
calcite, limestone fragments 1/8 to 1/16"
adjacent to healed fractures of white calcite,
white to olive carbonate laminations/bands 1/8
to 2" at 15 to 20 degrees from horizontal
observed from 108.42 to 111.42', very slight
HCL reaction on some fresh fractured surfaces
from hammer breaks

105

1

0.1/1

0

F

II

110

3

5/5

38

F,WS

I,II

17.1

94.10

170.2

Run Number:3
M.C.=0.3%

115

4

5/5

50

F,WS

I,II

17.2

56.78

159.8

Run Number:4
M.C.=0.4%

117.0

5219.3

Metamorphosed Shale; gray to dark gray,
siliceous, extremely strong to very strong,
massive, highly fractured olive to light olive CO3
cement on structures and healed fractures,
CO3 (white)

120

Continued Next Page

HKM
EngineeringHKM Engineering Inc.
222 North 32nd St.
Billings, MT 59101
Telephone: (406) 656-6399
Fax: (406) 656-6398

STARTED 10/23/99 FINISHED 10/24/99

DRILL CO. RB&G Eng. DRILL RIG CME-55

DRILLER BH ASST DRILLER

LOGGED BY JM APPROVED BY JTS

Project No. 8M087.155

LOG OF DRILLHOLE NO. DH99-1

Sheet 8 of 8

CLIENT
Montana Dept of Natural Resources and Conservation

ARCHITECT/ENGINEER
HKM Engineering Inc.

SITE
Bair Reservoir, Montana

PROJECT
Bair Dam

(continued)

GRAPHIC LOG

DEPTH (FT.)

Core Run (#)

Recovery

R.Q.D. %

Weathering Index

Strength Index

Permeability (ft/yr)

Point Load Index

Unit Weight (pcf)

ADDITIONAL
DATA/
REMARKS

123.4

5213.5

Metamorphosed/Siliceous Shale; gray to dark gray, massive, fresh, very strong, dry, highly fractured, carbonate (calcite) olive green plus iron staining (red brown) showing on fracture planes as above

125

6

5/5

9

F,WS

I,II

9.8

128.4

5208.5

Bottom of Hole at 128.42 ft.

HKM
Engineering

HKM Engineering Inc.
222 North 32nd St.
Billings, MT 59101
Telephone: (406) 656-6399
Fax: (406) 656-6398

STARTED	10/23/99	FINISHED	10/24/99
DRILL CO.	RB&G Eng.	DRILL RIG	CME-55
DRILLER	BH	ASST DRILLER	
LOGGED BY	JM	APPROVED BY	JTS

Project No. 8M087.155

WELL COMPLETION LOG NO. DH99-01

Sheet 1 of 1

CLIENT
Montana Dept of Natural Resources and ConservationENGINEER
HKM Engineering Inc.SITE
Bair Reservoir, MontanaPROJECT
Bair Dam

Surface Elev.: 5336.9 ft. Datum: MSL

WELL
CONSTRUCTION
Stand Pipe
CoverOpen System Piezometer
(99-1a)Observation Well
(99-1b)

DEPTH (FT.)

0.5 Steel Protective Cover (0' - .5') 5336.4
Bentonite Hole Plug (.5' - 48.67')48.7 CSSI 10x20 Silica Sand Filter Pack (48.67' - 5288.3
77.0')

77.0 Bentonite Hole Plug (77' - 109.5') 5259.9

109.5 CSSI 10x20 Silica Sand Filter Pack (109.5' - 5227.4
115.0 115') 5221.9

Bentonite Hole Plug (115' - 128.4')

128.4 5208.5

1" PVC Pipe
Typical1" PVC Pipe
Typical1" Slotted
(0.020") PVC
(50.0'-75.0')1" Slotted
(0.020") PVC
(111.6'-113.5')**HKM**
EngineeringHKM Engineering Inc.
222 North 32nd St.
Billings, MT 59101
Telephone: (406) 656-6399
Fax: (406) 656-6398

STARTED	10/23/99	FINISHED	10/24/99
DRILL CO.	RB&G Eng	DRILL RIG	CME-55
DRILLER	BH	ASST DRILLER	
LOGGED BY	JM	APPROVED	JTS

LOG OF BOREHOLE NO. DH99-2

Project No. 8M087.155

Sheet 1 of 5

CLIENT
Montana Dept. of Natural Resources and Conservation

ARCHITECT/ENGINEER
HKM Engineering Inc.

SITE
Bair Reservoir, Montana

PROJECT
Bair Dam

	GRAPHIC LOG	DEPTH (FT.)	SAMPLES			TESTS			ADDITIONAL DATA/REMARKS
			TYPE	BLOWS PER 6"	NUMBER	N. RECOVERED IN. DRIVEN	POCKET PENE-TROMETER, TSF	N VALUE BLOWS/FOOT	
								PL WC LL	
Surface Elev.: 5301.3 ft. Datum: MSL								10 20 30 40	
Gravel with Sand and Silt (GM); loose, dry to damp, very coarse gravel to cobbles, large boulder at 10' (Rock Shell)				5 6 4	SS-1	5/18 28%			
		5		5 13 24	SS-2	7/18 39%			
10.0		10		2 9 10	SS-3	10/18 56%			
Gravelly Clay with Sand (CL) to Clayey Gravel with Sand (GC); medium stiff to hard/compact to very dense, damp, brown, coarse to fine gravel (Semi-pervious Embankment)				8 9 10	SS-4	10/18 56%			
Gravel is fine		15							
		20							

Continued Next Page

HKM
Engineering

HKM Engineering Inc.
222 North 32nd St.
Billings, MT 59101
Telephone: (406) 656-6399
Fax: (406) 656-6398

STARTED	11/2/99	FINISHED	11/3/99
DRILL CO.	RB&G Eng.	DRILL RIG	CME-55
DRILLER	BH	ASST DRILLER	
LOGGED BY	SS	APPROVED BY	JTS

PROJECT **Bair Dam**

Permeability:
21.5'-30.0', k=591 ft/yr
29.0'-35.0', k=453 ft/yr

HKM
Engineering

STARTED	11/2/99	FINISHED	11/3/99
DRILL CO.	RB&G Eng.	DRILL RIG	CME-55
DRILLER	BH	ASST DRILLER	
LOGGED BY	SS	APPROVED BY	JTS

LOG OF BOREHOLE NO. DH99-2

Project No. 8M087.155


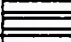
Sheet 3 of 5

CLIENT
Montana Dept. of Natural Resources and Conservation

ARCHITECT/ENGINEER
HKM Engineering Inc.

SITE
Bair Reservoir, Montana

PROJECT
Bair Dam

	GRAPHIC LOG	DEPTH (FT.)	SAMPLES				TESTS				ADDITIONAL DATA/REMARKS		
			TYPE	BLOWS PER 6"	NUMBER	IN. RECOVERED IN. DRIVEN	POCKET PENE-TROMETER, TSF	N VALUE BLOWS/FOOT					
								PL	WC	LL			
(continued)													
Silty Clayey Fine Gravel (GM); dense, dry to damp, light brown				27 22 14	SS-8	11/18 61%	.75 2.5						<input type="checkbox"/>
45.0 5256.3		45											
45.5 Meta Quartzite Shale 5255.8				60/4"	SS-10	4/18 22%							>8 <input type="checkbox"/>
See Sheet 4 for Continuation of Core Drilled Portion of Log.													
Bottom of Hole at 67.0 ft. Groundwater Encountered at 40.0 ft. (11/2/1999)													

Continued Next Page

Continued Next Page

HKM
Engineering

HKM Engineering Inc.
222 North 32nd St.
Billings, MT 59101
Telephone: (406) 656-6399
Fax: (406) 656-6398

STARTED	11/2/99	FINISHED	11/3/99
DRILL CO. RB&G Eng.		DRILL RIG	CME-55
DRILLER	BH	ASST DRILLER	
LOGGED BY	SS	APPROVED BY	JTS

Project No. 8M087.155

LOG OF DRILLHOLE NO. DH99-2

Sheet 4 of 5

CLIENT
Montana Dept of Natural Resources and ConservationARCHITECT/ENGINEER
HKM Engineering Inc.SITE
Bair Reservoir, MontanaPROJECT
Bair Dam

(continued)

GRAPHIC LOG

DEPTH (FT.)

Core Run (#)

Recovery

R.Q.D. %

Weathering Index

Strength Index

Permeability (ft/yr)

Point Load Index

Unit Weight (pcf)

ADDITIONAL
DATA/
REMARKS

45.5 5255.8

46.4 5254.9
Meta Quartzite (Siliceous) Shale; dark maroon, strong, highly fractured, calcite, olive to dark brown carbonate cement on fracture planes

47.6 5253.7

49.6 5251.7
Very highly fractured blue green calcareous cement on open fractures, intermittent bands of crystalline olive to blue green limestone53.3 5248.1
Less open fractures, numerous healed fractures with blue green to olive calcareous cement, banding of olive green crystalline appearing limestone as above throughout, light gray to light greeny gray 49.5-50.2', maroon to lavender 50.2-51.5', gray to light maroon/lavender 51.5-53.25', less fractured/broken rock58.3 5243.1
Light gray to dark gray at 53.75', cement on fractures as above59.3 5242.1
Meta Quartzite Shale (as above)

Meta Quartzite Shale (as above); mottled

Continued Next Page

HKM
EngineeringHKM Engineering Inc.
222 North 32nd St.
Billings, MT 59101
Telephone: (406) 656-6399
Fax: (406) 656-6398

STARTED	11/2/99	FINISHED	11/3/99
DRILL CO.	RB&G Eng.	DRILL RIG	CME-55
DRILLER	BH	ASST DRILLER	
LOGGED BY	JM	APPROVED BY	JTS

LOG OF DRILLHOLE NO. DH99-2

Project No. 8M087.155

Sheet 5 of 5

CLIENT
Montana Dept of Natural Resources and Conservation

ARCHITECT/ENGINEER
HKM Engineering Inc.

SITE
Bair Reservoir, Montana

PROJECT
Bair Dam

GRAPHIC LOG	DEPTH (FT.)	Core Run (#)	Recovery	R.Q.D. %	Weathering Index	Strength Index	Permeability (ft/yr)	Point Load Index	Unit Weight (pcf)	ADDITIONAL DATA/REMARKS
(continued)										
gray, olive, red brown to dark red brown, very strong HCL reaction 59.25-63.25		7	4/4	10	F,WS	III,IV	8.0			
63.3 5238.1										
Meta Quartzite Shale; strong, fractured, healed fractures as above, cement not as apparent as uphole, cement on fractures dark red calcite	65	8	1.5/3.8	40	F,WS	III,IV	8.0	55.47	166.3	Run Number:8 M.C.=0.4%
67.0 5234.3										
Bottom of Hole at 67 ft.										

HKM
Engineering

HKM Engineering Inc.
222 North 32nd St.
Billings, MT 59101
Telephone: (406) 656-6399
Fax: (406) 656-6398

STARTED	11/2/99	FINISHED	11/3/99
DRILL CO.	RB&G Eng.	DRILL RIG	CME-55
DRILLER	BH	ASST DRILLER	
LOGGED BY	JM	APPROVED BY	JTS

Project No. 8M087.155

WELL COMPLETION LOG NO. DH99-02

Sheet 1 of 1

CLIENT
Montana Dept of Natural Resources and ConservationENGINEER
HKM Engineering Inc.SITE
Bair Reservoir, MontanaPROJECT
Bair Dam

Surface Elev.: 5301.3 ft. Datum: MSL

DEPTH (FT.)

WELL
CONSTRUCTION
Stand Pipe
CoverOpen System Piezometer
(99-2a)Observation Well
(99-2b)

3.0 Steel Protective Cover (0' - .5') 5298.3

Bentonite Hole Plug (.5' - 48.67')

20.0 CSSI 10x20 Silica Sand Filter Pack (48.67' - 77.0') 5281.3

40.0 Bentonite Hole Plug (77' - 109.5') 5261.3

55.0 CSSI 10x20 Silica Sand Filter Pack (109.5' - 115') 5246.3

60.0 Bentonite Hole Plug (115' - 128.4') 5241.3

67.0 5234.3

1" PVC Pipe
Typical1" PVC Pipe
Typical1" Slotted
(0.020") PVC
(25.0'-40.0')1" Slotted
(0.020") PVC
(56.5'-58.5')**HKM**
EngineeringHKM Engineering Inc.
222 North 32nd St.
Billings, MT 59101
Telephone: (406) 656-6399
Fax: (406) 656-6398

STARTED	11/2/99	FINISHED	11/3/99
DRILL CO.	RB&G Eng	DRILL RIG	CME-55
DRILLER	BH	ASST DRILLER	
LOGGED BY	JM	APPROVED	JTS

ARCHITECT/ENGINEER
HKM Engineering Inc.

PROJECT **Bair Dam**

ADDITIONAL
DATA/
REMARKS

STARTED	10/20/99	FINISHED	10/21/99
DRILL CO.	RB&G Eng.	DRILL RIG	CME-55
DRILLER	BH	ASST DRILLER	
LOGGED BY	JM	APPROVED BY	JTS

Project No. 8M087.155

LOG OF BOREHOLE NO. DH99-3

Sheet 2 of 4

CLIENT
Montana Dept. of Natural Resources and ConservationARCHITECT/ENGINEER
HKM Engineering Inc.SITE
Bair Reservoir, MontanaPROJECT
Bair Dam

(continued)	GRAPHIC LOG	DEPTH (FT.)	SAMPLES				TESTS				ADDITIONAL DATA/REMARKS	
			TYPE	BLOWS PER 6"	NUMBER	IN. RECOVERED IN. DRIVEN	POCKET PENE-TROMETER, TSF	N VALUE BLOWS/FOOT				
								PL	WC	LL		
											</	

Continued Next Page

HKM
EngineeringHKM Engineering Inc.
222 North 32nd St.
Billings, MT 59101
Telephone: (406) 656-6399
Fax: (406) 656-6398

STARTED	10/20/99	FINISHED	10/21/99
DRILL CO.	RB&G Eng.	DRILL RIG	CME-55
DRILLER	BH	ASST DRILLER	
LOGGED BY	JM	APPROVED BY	JTS

ARCHITECT/ENGINEER
HKM Engineering Inc.

PROJECT **Bair Dam**


ADDITIONAL
DATA/
REMARKS

STARTED	10/20/99	FINISHED	10/21/99
DRILL CO.	RB&G Eng.	DRILL RIG	CME-55
DRILLER	BH	ASST DRILLER	
LOGGED BY	JM	APPROVED BY	JTS

Project No. 8M087.155

LOG OF DRILLHOLE NO. DH99-3

Sheet 4 of 4

CLIENT Montana Dept of Natural Resources and Conservation				ARCHITECT/ENGINEER HKM Engineering Inc.										
SITE Bair Reservoir, Montana				PROJECT Bair Dam										
				GRAPHIC LOG	DEPTH (FT.)	Core Run (#)	Recovery	R.Q.D. %	Weathering Index	Strength Index	Permeability (ft/yr)	Point Load Index	Unit Weight (pcf)	ADDITIONAL DATA/REMARKS
(continued)														
41.2 5226.2					4	0.7/1.5	0	WM	II,III	512				
Strong HCL reaction 41.2-41.5', calcite intergranular with green to yellow green shale					5	0.2/0.2	0			512				
					6	1.3/1.3	0	WM	II,III	512				
43.5 5223.9					7	0.8/0.8	0	WM	II,III	512				
As above, layered green limey shale interlayered with dark green to black/maroon when dry, 46.7-47.5 strong HCL reaction, highly fractured 43.3-47.5					8	4.2/4.2	0	WM	II,III	492				
47.5 5219.9					9	1.4/1.4	0	WM	II,III	492				
Dark gray to black Metamorphosed Shale; very strong					10	1.2/1.4	0	WM	III	492				
					11	0.6/1.8	0	WM	III	492				
52.5 5214.9						1.2								
						1.3								
Bottom of Hole at 52.5 ft.														

HKM
Engineering

 HKM Engineering Inc.
 222 North 32nd St.
 Billings, MT 59101
 Telephone: (406) 656-6399
 Fax: (406) 656-6398

STARTED	10/20/99	FINISHED	10/21/99
DRILL CO.	RB&G Eng.	DRILL RIG	CME-55
DRILLER	BH	ASST DRILLER	
LOGGED BY	JM	APPROVED BY	JTS

Project No. 8M087.155

WELL COMPLETION LOG NO. DH99-03

Sheet 1 of 1

CLIENT

Montana Dept of Natural Resources and Conservation

ENGINEER

HKM Engineering Inc.

SITE

Bair Reservoir, Montana

PROJECT

Bair Dam

WELL
CONSTRUCTION
Stand Pipe
Cover

Surface Elev.: 5267.4 ft. Datum: MSL

DEPTH (FT.)

Open System Piezometer
(99-3a)Observation Well
(99-3b)

2.5 Protective Steel Box and Cement Seal (0' -2.5') 5264.9

Bentonite Hole Plug (2.5' - 18')

5

10

15

18.0 CSSI 10x20 Silica Sand Filter Pack (18' - 27.8') 5249.4

20

25

28.8 Slough (27.8'-28.8') 5238.6

Bentonite Hole Plug (28.8' - 47.5')

30

35


40

47.5 CSSI 10x20 Silica Sand Filter Pack (47.5' - 52.5') 5219.9

45

52.5 5214.9

50

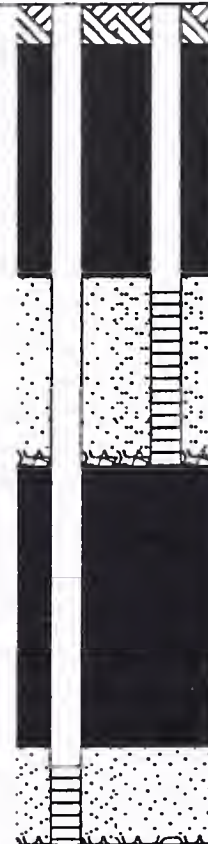1" PVC Pipe
Typical1" PVC Pipe
Typical1" Slotted
(0.020") PVC
(47.5'-52.5')1" Slotted
(0.020") PVC
(18'-28.8')**HKM**
EngineeringHKM Engineering Inc.
222 North 32nd St.
Billings, MT 59101
Telephone: (406) 656-6399
Fax: (406) 656-6398

STARTED	10/20/99	FINISHED	10/21/99
DRILL CO.	RB&G Eng	DRILL RIG	CME-55
DRILLER	BH	ASST DRILLER	
LOGGED BY	JM	APPROVED	JTS

Project No. 8M087.155

LOG OF DRILLHOLE NO. DH99-4

Sheet 2 of 4

CLIENT
Montana Dept of Natural Resources and ConservationARCHITECT/ENGINEER
HKM Engineering Inc.SITE
Bair Reservoir, MontanaPROJECT
Bair Dam

Surface Elev.: 5323.5 ft. Datum: MSL

GRAPHIC LOG

DEPTH (FT.)

Core Run (#)

Recovery

R.Q.D. %

Weathering Index

Strength Index

Permeability (ft/yr)

Point Load Index

Unit Weight (pcf)

ADDITIONAL
DATA/
REMARKS

11.5

5312.0

Meta Quartzite Shale; maroon to deep lavender, moderately strong to strong, highly fractured, calcite and calcareous olive cement on open fractures, fractures healed with calcite cement, some fractures show red brown iron staining

14.2

5309.3

Meta Quartzite (Siliceous) Shale; as above, less infilling of fractures with cement, most fractures appear to be induced by drilling, high density of healed fractures (calcite cement)

16.7

5306.8

Meta Quartzite Shale; as above, highly fractured olive calcite showing on fracture planes

18.2

5305.3

as above

19.2

5304.3

Meta Quartzite Shale; maroon to dark gray,

Continued Next Page

HKM
EngineeringHKM Engineering Inc.
222 North 32nd St.
Billings, MT 59101
Telephone: (406) 656-6399
Fax: (406) 656-6398

STARTED	10/29/99	FINISHED	11/2/99
DRILL CO.	RB&G Eng.	DRILL RIG	CME-55
DRILLER	BH	ASST DRILLER	
LOGGED BY	JM	APPROVED BY	JTS

LOG OF DRILLHOLE NO. DH99-4

Project No. 8M087.155

Sheet 3 of 4

CLIENT
Montana Dept of Natural Resources and Conservation

ARCHITECT/ENGINEER
HKM Engineering Inc.

SITE
Bair Reservoir, Montana

PROJECT
Bair Dam

	GRAPHIC LOG	DEPTH (FT.)	Core Run (#)	Recovery	R.Q.D. %	Weathering Index	Strength Index	Permeability (ft/yr)	Point Load Index	Unit Weight (pcf)	ADDITIONAL DATA/REMARKS
(continued)											
moderately strong to strong, highly fractured, numerous healed fractures, all fractures have calcite carbonate deposits, core breaks along two planes with single moderate blow of hammer			5	5/5	33	F,WS	III,IV	1876			
24.2 5299.3		25									
Meta Quartzite Shale; olive gray to dark gray			6	4/4	9	WS	III	1006			
28.2 5295.3											
as above, highly fractured			7	1/1	0	WS	III	1006			
29.2 5294.3											
as above, x-bedding			8	1.4/1.4	0	WS	III	1006			
30.6 5292.9		30	9	1/1	0	WS	III	1006			
as above											
Water level during drilling			10	2.3/2.5	14	WS	II,III	1006			
			11	1.3/1.3	45	WS	III	134			
		35	12	1.8/1.8	67	WS	III	134	48.87	163.9	Run Number: 12 M.C.=0.5%
			13	0/0.2				134			
			14	0.2/0.4	0			134			
37.8 5285.7			15	1.2/1.4	0	WS	III	134			
Meta Quartzite Shale; as above, highly fractured, calcite on fractures, olive gray											
39.2 5284.3			16	1.6/1.8	0	WS,WM	III	134			
as above, higher fracture density		40									

Continued Next Page

HKM
Engineering

HKM Engineering Inc.
222 North 32nd St.
Billings, MT 59101
Telephone: (406) 656-6399
Fax: (406) 656-6398

STARTED	10/29/99	FINISHED	11/2/99
DRILL CO.	RB&G Eng.	DRILL RIG	CME-55
DRILLER	BH	ASST DRILLER	
LOGGED BY	JM	APPROVED BY	JTS

Project No. 8M087.155

LOG OF DRILLHOLE NO. DH99-4

Sheet 4 of 4


CLIENT
Montana Dept of Natural Resources and ConservationARCHITECT/ENGINEER
HKM Engineering Inc.SITE
Bair Reservoir, MontanaPROJECT
Bair Dam

(continued)	GRAPHIC LOG	DEPTH (FT.)	Core Run (#)	Recovery	R.Q.D. %	Weathering Index	Strength Index	Permeability (ft/yr)	Point Load Index	Unit Weight (pcf)	ADDITIONAL DATA/REMARKS
40.9	5282.6		17	0.7/1.3	0	WM	III	134			
as above, olive to dark gray											
42.2	5281.3		18	1.5/2	0	WM		134			
as above, dark gray, abundant rust-colored calcite on fractures											
44.2	5279.3		19	0.8/0.8	0	WM	III	10.2			
			20	0.5/0.5	0	WM	IV	10.2			
45.0	5278.5		21	0/0.3				10.2			
		45	22	0.4/0.4	0	WM	IV	10.2			
46.1	5277.4										
Meta Quartzite Shale; abundant planar fractures filled with rust colored calcite, dark gray to olive gray with bands of light gray to green alteration, some chlorite			23	2.7/3.2	0	WM	III, IV	10.2			
49.3	5274.2		24	1.1/1.1	40	WM	III	10.2			
Shale as above with thicker, lighter bands											
50.4	5273.1	50	25	0.7/0.7	0	WM	III	10.2			
51.0	5272.5										
Meta Quartzite Shale; as above, brownish-gray, highly fractured											
Bottom of Hole at 51 ft.											

HKM
 Engineering

 HKM Engineering Inc.
 222 North 32nd St.
 Billings, MT 59101
 Telephone: (406) 656-6399
 Fax: (406) 656-6398

STARTED	10/29/99	FINISHED	11/2/99
DRILL CO.	RB&G Eng.	DRILL RIG	CME-55
DRILLER	BH	ASST DRILLER	
LOGGED BY	JM	APPROVED BY	JTS

Project No. 8M087.155		WELL COMPLETION LOG NO. DH99-04		Sheet 1 of 1	
CLIENT Montana Dept of Natural Resources and Conservation			ENGINEER HKM Engineering Inc.		
SITE Bair Reservoir, Montana			PROJECT Bair Dam		
			WELL CONSTRUCTION Stand Pipe Cover		
Surface Elev.: 5323.5 ft. Datum: MSL			Observation Well (99-4)		
3.0 Protective Steel Box and Cement Seal (0' - 3') 5320.5					
Bentonite Hole Plug (3' - 34')					
34.0 5289.5			1" PVC Pipe Typical		
CSSI 10x20 Silica Sand Filter Pack (34' - 40')			1" Slotted (0.020") PVC (34.5'-36.5')		
40.0 5283.5					
Bentonite Hole Plug					
51.0 5272.5					

WELL COMPLETION LOGS.GPJ MSE HKM.GDT 7/17/00



HKM Engineering Inc.
222 North 32nd St.
Billings, MT 59101
Telephone: (406) 656-6399
Fax: (406) 656-6398

STARTED	10/29/99	FINISHED	11/2/99
DRILL CO.	RB&G Eng	DRILL RIG	CME-55
DRILLER	BH	ASST DRILLER	
LOGGED BY	JM	APPROVED	JTS

HKM Engineering Inc.

Bair Dam

[illegible]

Continued Next Page

STARTED	10/25/99	FINISHED	10/26/99
DRILL CO.	RB&G Eng.	DRILL RIG	CME-55
DRILLER	BH	ASST DRILLER	
LOGGED BY	JM	APPROVED BY	JTS

Project No. 8M087.155

LOG OF DRILLHOLE NO. DH99-5

Sheet 5 of 6

CLIENT
Montana Dept of Natural Resources and ConservationARCHITECT/ENGINEER
HKM Engineering Inc.SITE
Bair Reservoir, MontanaPROJECT
Bair Dam

(continued)

GRAPHIC LOG

DEPTH (FT.)

Core Run (#)

Recovery

R.Q.D. %

Weathering Index

Strength Index

Permeability (ft/yr)

Point Load Index

Unit Weight (pcf)

ADDITIONAL
DATA/
REMARKS

Water level during drilling

▽

68.9

5266.9

Shale; dark maroon to gray, metamorphosed, highly fractured, calcite, olive green NO3 and CO3 deposits on fracture planes

73.2

5262.6

Quartzite Calcareous Shale; deep lavender, highly fractured, moderately strong, grading to white dolomitic shale/limestone at 74.3', has appearance of marble, lavender and bluish green banding at approximately 45 degrees from vertical throughout, all of RQD is in white "marble" at 74.8-78.17, weak HCL reaction on hammer broken core and shavings

77.1

5258.7

Metamorphosed Quartzitic Limestone (marble?); very light gray, very fine grained, strong to moderately strong, thin laminations of layered quartzite, dark lavender quartzitic appearing metamorphosed limestone at 79.92'

Continued Next Page

HKM
EngineeringHKM Engineering Inc.
222 North 32nd St.
Billings, MT 59101
Telephone: (406) 656-6399
Fax: (406) 656-6398

STARTED	10/25/99	FINISHED	10/26/99
DRILL CO.	RB&G Eng.	DRILL RIG	CME-55
DRILLER	BH	ASST DRILLER	
LOGGED BY	JM	APPROVED BY	JTS

Project No. 8M087.155

LOG OF DRILLHOLE NO. DH99-5

Sheet 6 of 6

CLIENT
Montana Dept of Natural Resources and ConservationARCHITECT/ENGINEER
HKM Engineering Inc.SITE
Bair Reservoir, MontanaPROJECT
Bair Dam

(continued)

GRAPHIC LOG

DEPTH (FT.)

Core Run (#)

Recovery

R.Q.D. %

Weathering Index

Strength Index

Permeability (ft/yr)

Point Load Index

Unit Weight (pcf)

ADDITIONAL
DATA/
REMARKS

81.7

5254.1

As above, dark maroon/gray shale, cementing of fractures, calcite and light olive green calcareous, change in core color to olive at 87.3'

85

7

4.7/4.7

47

F

III,IV

125

122.15

181.8

Run Number:7
M.C.=0.1%

86.4

5249.4

Metamorphosed Quartzitic Limestone (marble?); white to light gray with intermittent banding of light olive and lavender/maroon

90

8

4.9/5.1

41

F

III,IV

125

149.40

171.6

Run Number:8
M.C.=0.1%

91.5

5244.3

92.6

5243.2


Appearing Shale, lavender to dark maroon, dark gray with laminations of blue green to light olive dolomitic limestone, fresh, fractured, fracture planes calcareous olive green, white and red brown deposited cementing

Bottom of Hole at 92.6 ft.

HKM
EngineeringHKM Engineering Inc.
222 North 32nd St.
Billings, MT 59101
Telephone: (406) 656-6399
Fax: (406) 656-6398

STARTED	10/25/99	FINISHED	10/26/99
DRILL CO.	RB&G Eng.	DRILL RIG	CME-55
DRILLER	BH	ASST DRILLER	
LOGGED BY	JM	APPROVED BY	JTS

Project No. 8M087.155		WELL COMPLETION LOG NO. DH99-05		Sheet 1 of 1	
CLIENT Montana Dept of Natural Resources and Conservation			ENGINEER HKM Engineering Inc.		
SITE Bair Reservoir, Montana			PROJECT Bair Dam		
Surface Elev.: 5335.8 ft. Datum: MSL 2.0 Protective Steel Box and Cement Seal (+2.51 - 2') Bentonite Hole Plug (2' - 45')			WELL CONSTRUCTION Stand Pipe Cover		
			Open System Piezometer (99-5a) Observation Well (99-5b)		
45.0 CSSI 10x20 Silica Sand Filter Pack (45' - 57.5') 57.5 Bentonite Hole Plug (57.5' - 77') 77.0 CSSI 10x20 Silica Sand Filter Pack (77' - 82') 82.0 Bentonite Hole Plug (82' - 92.6') 92.6			DEPTH (FT.) 5 10 15 20 25 30 35 40 45 50 55 60 65 70 75 80 85 90		
			1" PVC Pipe Typical → ← 1" PVC Pipe Typical		
			1" Slotted (0.020") PVC (47.5'-57.5')		
			1" Slotted (0.020") PVC (80'-81.5')		
			1" Slotted (0.020") PVC (80'-81.5')		
HKM Engineering Inc.
 222 North 32nd St.
 Billings, MT 59101
 Telephone: (406) 656-6399
 Fax: (406) 656-6398

STARTED	10/25/99	FINISHED	10/26/99
DRILL CO.	RB&G Eng	DRILL RIG	CME-55
DRILLER	BH	ASS'T DRILLER	
LOGGED BY	JM	APPROVED	JTS

Project No. 8M087.163

WELL COMPLETION LOG NO. DH-5

Sheet 1 of 1

CLIENT

Montana Department of Natural Resources

ENGINEER

HKM Engineering Inc

SITE

Checkerboard, Montana

PROJECT

Bair Dam Well Reconstruction

Surface Elev.:

DEPTH (FT.)

WELL
CONSTRUCTION
Stand Pipe
CoverOpen System Piezometer
(99-5a)Observation Well
(99-5b)

3.0

Protective 4" Square Steel Tube and Flush Mount
Cover

Bentonite Hole Plug (3'-45')

5

10

15

20

25

30

35

40

45.0

CSSI 10x20 Silica Sand Filter Pack (45'-59')

50

55

59.0

Bentonite Hole Plug (59'-77')

60

65

70

75

77.0

CSSI 10x20 Silica Sand Filter Pack (77'-82')

80

82.0

1" Slotted
(0.02") PVC
(79'-81')1" Slotted
(0.02") PVC
(47'-57')**HKM**
EngineeringHKM Engineering Inc.
222 North 32nd St.
Billings, MT 59101
Telephone: (406) 656-6399
Fax: (406) 656-6398

STARTED

5/1/03

FINISHED

5/2/03

DRILL CO.

O'Keefe

DRILL RIG

B-65

DRILLER

DC

ASST DRILLER

SM

LOGGED BY

JLG

APPROVED

SE

WELL COMPLETION BLANKWEL.GPJ MSE HKM.GDT 10/20/03

Project No. 8M087.155

LOG OF BOREHOLE NO. DH99-6

Sheet 1 of 5

CLIENT
Montana Dept. of Natural Resources and ConservationARCHITECT/ENGINEER
HKM Engineering Inc.SITE
Bair Reservoir, MontanaPROJECT
Bair Dam

Surface Elev.: 5301.6 ft. Datum: MSL	GRAPHIC LOG	DEPTH (FT.)	SAMPLES			TESTS				ADDITIONAL DATA/REMARKS		
			TYPE	BLOWS PER 6"	NUMBER	IN. RECOVERED IN. DRIVEN	POCKET PENE-TROMETER, TSF	N VALUE BLOWS/FOOT				
								PL	WC		LL	
Silty Gravel with Sand (GM); compact, slightly moist, gray, tabular and angular, boulder and cobble size riprap (rock shell)		7 8 11	SS-1	8/18 44%								
5.0	5296.6	5	4 3 4	SS-2	12/18 67%						Sample:SS-2 M.C.=19.5%	
Gravelly Lean to Fat Clay (CL-CH); firm to stiff, moist, gray to red brown, subrounded to rounded cobbles at 2-6', varies to sandy lean clay with gravel (CL); sof to stiff with depth, red brown, scattered rocks 2" plus (limestone and metashale throughout) (impervious embankment)		10	3 4 6	SS-3	13/18 72%						Sample:SS-3 M.C.=24.8% USCS=CH Gravel=17% Sand=32% Fines=51% LL=63 PI=45	
Permeability: 13.5'-18.5', k=0 ft/yr 13.5'-23.5', k=15 ft/yr												
Extra Samples Taken in DH-6a SH-1 10'-12', 24"/24"=100% M.C.=31.3% Cohesion=640 psf Phi=18.7 degrees Dry Unit Wt=85.1 pcf		15	3 6 7	SS-4	16/18 89%	1.75 2.5					Sample:SS-4 M.C.=28.3%	
SH-2 18.5'-20.2', 20"/24"=83%												
		20										

Continued Next Page

Sample:SS-2
M.C.=19.5%Sample:SS-3
M.C.=24.8%
USCS=CH
Gravel=17%
Sand=32%
Fines=51%
LL=63 PI=45Sample:SS-4
M.C.=28.3%**HKM**
EngineeringHKM Engineering Inc.
222 North 32nd St.
Billings, MT 59101
Telephone: (406) 656-6399
Fax: (406) 656-6398

STARTED	10/27/99	FINISHED	10/29/99
DRILL CO. RB&G Eng.		DRILL RIG	CME-55
DRILLER	BH	ASS'T DRILLER	
LOGGED BY	JM	APPROVED BY	JTS

Project No. 8M087.155

LOG OF BOREHOLE NO. DH99-6

Sheet 2 of 5

CLIENT
Montana Dept. of Natural Resources and Conservation

ARCHITECT/ENGINEER
HKM Engineering Inc.

SITE
Bair Reservoir, Montana

PROJECT
Bair Dam

(continued)	GRAPHIC LOG	DEPTH (FT.)	SAMPLES				TESTS				ADDITIONAL DATA/REMARKS		
			TYPE	BLOWS PER 6"	NUMBER	IN. RECOVERED IN. DRIVEN	POCKET PENE- TROMETER, TSF	N VALUE BLOWS/FOOT □					
								PL	WC	LL			
								10	20	30	40		
			5 8 11		SS-5	17/18 94%	2.75 4.5		□	●		63	Sample:SS-5 M.C.=27.4% USCS=CH Gravel=7% Sand=32% Fines=61% LL=63 PI=42 Dispersion=10.7%
		25	5 19 21		SS-6	8/18 44%	2.5				□		
		30	8 10 10		SS-7	10/18 56%	2.5		□				
		35	4 8 9		SS-8	18/18 100%	1.5 2.5		□				
		40											

Continued Next Page

Continued Next Page

HKM
Engineering

HKM Engineering Inc.
222 North 32nd St.
Billings, MT 59101
Telephone: (406) 656-6399
Fax: (406) 656-6398

STARTED	10/27/99	FINISHED	10/29/99
DRILL CO.	RB&G Eng.	DRILL RIG	CME-55
DRILLER	BH	ASST DRILLER	
LOGGED BY	JM	APPROVED BY	JTS

Project No. 8M087.155

LOG OF DRILLHOLE NO. DH99-6

Sheet 4 of 5

CLIENT

Montana Dept of Natural Resources and Conservation

ARCHITECT/ENGINEER

HKM Engineering Inc.

SITE

Bair Reservoir, Montana

PROJECT

Bair Dam

(continued)

		GRAPHIC LOG	DEPTH (FT.)	Core Run (#)	Recovery	R.Q.D. %	Weathering Index	Strength Index	Permeability (ft/yr)	Point Load Index	Unit Weight (pcf)	ADDITIONAL DATA/REMARKS
42.0	5259.6											
42.8	5258.9			1	0.8/8	0	F	III				
44.7	5256.9			2	1.9/1.9		F,WS		173			
47.8	5253.9		45	3	3/3	33	F,WS	II	173	74.76	166.0	Run Number:3 M.C.=0.2%
49.3	5252.3			4	1.6/1.6	0	F,WS	II	173	131.78	176.0	Run Number:4 M.C.=0.2%
52.7	5248.9		50	5	3.4/3.4	14	F,WS	III	173			
57.7	5243.9		55	6	5/5	30	F,WS	III,IV	242			
			60	7	2.5/2.5	44	F,WS	III,IV	242			

Continued Next Page

HKM
Engineering

 HKM Engineering Inc.
 222 North 32nd St.
 Billings, MT 59101
 Telephone: (406) 656-6399
 Fax: (406) 656-6398

STARTED	10/27/99	FINISHED	10/28/99
DRILL CO.	RB&G Eng.	DRILL RIG	CME-55
DRILLER	BH	ASST DRILLER	
LOGGED BY	JM	APPROVED BY	JTS


Project No. 8M087.155

LOG OF DRILLHOLE NO. DH99-6

Sheet 5 of 5

CLIENT Montana Dept of Natural Resources and Conservation	ARCHITECT/ENGINEER HKM Engineering Inc.
--	--

SITE Bair Reservoir, Montana	PROJECT Bair Dam
---------------------------------	---------------------

	GRAPHIC LOG	DEPTH (FT.)	Core Run (#)	Recovery	R.Q.D. %	Weathering Index	Strength Index	Permeability (ft/yr)	Point Load Index	Unit Weight (pcf)	ADDITIONAL DATA/REMARKS
(continued)											
60.2 Quartzite Shale; maroon, dark lavender, moderately strong to strong, fresh cement on fracture planes, calcite, red brown iron staining, blue green calcareous, noted small intergranular calcite (quartz appearance) in all meta shale and quartzite shale		5241.4	8	2.5/2.5	32		III	242			
62.8		5238.9									
Bottom of Hole at 62.75 ft.											

HKM
EngineeringHKM Engineering Inc.
222 North 32nd St.
Billings, MT 59101
Telephone: (406) 656-6399
Fax: (406) 656-6398

STARTED	10/27/99	FINISHED	10/28/99
DRILL CO.	RB&G Eng.	DRILL RIG	CME-55
DRILLER	BH	ASST DRILLER	
LOGGED BY	JM	APPROVED BY	JTS

CLIENT
Montana Dept. of Natural Resources and Conservation

ARCHITECT/ENGINEER
HKM Engineering Inc.

SITE **Bair Reservoir, Montana**

PROJECT **Bair Dam**

(continued)	GRAPHIC LOG	DEPTH (FT.)	SAMPLES				TESTS			ADDITIONAL DATA/REMARKS	
			TYPE	BLOWS PER 6"	NUMBER	IN. RECOVERED IN. DRIVEN	POCKET PENE-TROMETER, TSF	N VALUE BLOWS/FOOT □			
								PL	WC		LL
23.0	5297.4		SH-1	19/24 79%						Sample: SH-1 M.C.=17.4% Phi=35.5 degees Cohesion=360psf Dry Density=108.3pcf	
Clayey Sand with Gravel (SC) to Clayey Gravel with Sand (GC); compact to dense, moist, yellowish brown, scattered angular/tabular dark gray shale 1/4" to 2" showing throughout, similar in character to semi-pervious material in dam embankment		25	SS-6	13/18 72%						Sample: SS-6 M.C.=12.1%	
Water measured in casing between 31.5' (11/8/99) and 28.42' (11/9/99); believed to be drilling water.		30	SS-7	12/18 67%						Sample: SS-7 M.C.=11.2% USCS=GC Gravel=31% Sand=28% Fines=41% LL=26 PI=10	
36.8	5283.7	35	SS-8	0/18 0%						Sample: SS-8 M.C.=16.2%	
See Sheet 3 for Continuation of Core Drilled Portion of Log. Bottom of Hole at 98.6 ft. Groundwater Not Encountered. (11/9/1999)		40									
Continued Next Page											

Continued Next Page

HKM

Engineering

HKM Engineering Inc.
222 North 32nd St.
Billings, MT 59101
Telephone: (406) 656-6399
Fax: (406) 656-6398

STARTED	11/3/99	FINISHED	11/9/99
DRILL CO.	RB&G Eng.	DRILL RIG	CME-55
DRILLER	BH	ASST DRILLER	
LOGGED BY	JM	APPROVED BY	JTS

Project No. 8M087.155

LOG OF DRILLHOLE NO. DH99-7

Sheet 3 of 6

CLIENT
Montana Dept of Natural Resources and ConservationARCHITECT/ENGINEER
HKM Engineering Inc.SITE
Bair Reservoir, MontanaPROJECT
Bair Dam

(continued)

GRAPHIC LOG

DEPTH (FT.)

Core Run (#)

Recovery

R.Q.D. %

Weathering Index

Strength Index

Permeability (ft/yr)

Point Load Index

Unit Weight (pcf)

ADDITIONAL
DATA/
REMARKS

25

30

35

36.8

5283.7

37.5

5282.9

Siliceous Shale; dark gray, laminated olive to olive brown, highly fractured, rust/red brown deposits on fracture planes, laminated olive to olive brown, strong HCL reaction (limey shale or shaley limestone), dry

Gravelly Silty Clay with Sand (CL-ML); hard, slightly moist, yellow gray, highly weathered

Continued Next Page

HKM
EngineeringHKM Engineering Inc.
222 North 32nd St.
Billings, MT 59101
Telephone: (406) 656-6399
Fax: (406) 656-6398

STARTED	11/3/99	FINISHED	11/9/99
DRILL CO.	RB&G Eng.	DRILL RIG	CME-55
DRILLER	BH	ASS'T DRILLER	
LOGGED BY	JM	APPROVED BY	JTS

Project No. 8M087.155

LOG OF DRILLHOLE NO. DH99-7

Sheet 4 of 6

CLIENT
Montana Dept of Natural Resources and ConservationARCHITECT/ENGINEER
HKM Engineering Inc.SITE
Bair Reservoir, MontanaPROJECT
Bair Dam

(continued)

shale

42.8

5277.6

Siliceous Shale; dark gray, very fine grained, strong, interlayered with olive fine grained calcareous cement deposits in healed fractures (43.9-45-4'), (chert chalcedony?), no HCL reaction, gray to light gray, strong, aphanitic interlayered with bands of olive calcareous as above 45.4-47'

47.0

5273.4

48.0

5272.4

Crystalline Limestone, light gray to light olive gray, fine grained, moderately strong, dry

Limestone; light gray to light olive gray, fine grained, strong, fresh, dry, cave of clay and shale from 36.75 to 43', driller reported clay squeezing in at 37-43', removal of core tools, reamed hole to 43' to set casing and continue coring, light olive banding as above on approximate 0.2-0.5' centers throughout run

60.0

5260.4

Continued Next Page

GRAPHIC LOG

DEPTH (FT.)

Core Run (#)

Recovery

R.Q.D. %

Weathering Index

Strength Index

Permeability (ft/yr)

Point Load Index

Unit Weight (pcf)

ADDITIONAL
DATA/
REMARKS

Run Number:7
M.C.=0.2%
Slake
Durability=99.2%

Run Number:8
M.C.=0.1%

Run Number:9
M.C.=0.2%
Slake

HKM
Engineering

HKM Engineering Inc.
222 North 32nd St.
Billings, MT 59101
Telephone: (406) 656-6399
Fax: (406) 656-6398

STARTED	11/3/99	FINISHED	11/9/99
DRILL CO.	RB&G Eng.	DRILL RIG	CME-55
DRILLER	BH	ASS'T DRILLER	
LOGGED BY	JM	APPROVED BY	JTS

Project No. 8M087.155

LOG OF DRILLHOLE NO. DH99-7

Sheet 5 of 6

CLIENT
Montana Dept of Natural Resources and Conservation

ARCHITECT/ENGINEER
HKM Engineering Inc.

SITE
Bair Reservoir, Montana

PROJECT
Bair Dam

(continued)

Siliceous Shale; very fine grained to aphanitic,
light gray to gray, strong fresh, calcite
cementation healed fractures to open fractures

GRAPHIC LOG

DEPTH (FT.)

Core Run (#)

Recovery

R.Q.D. %

Weathering Index

Strength Index

Permeability (ft/yr)

Point Load Index

Unit Weight (pcf)

ADDITIONAL
DATA/
REMARKS

Durability=99.5%

Run Number:10
M.C.=0.2%Run Number:11
M.C.=0.1%
Slake
Durability=99.5%Run Number:12
M.C.=0.1%Run Number:13
M.C.=0.2%

77.6

5242.8

Dolomitic Marble; gray to light gray to light olive
gray, strong to very strong, massive, medium to
coarse grained with phenocrysts of calcite,
black to dark gray limestone, fresh, dry

Continued Next Page

HKM
Engineering

HKM Engineering Inc.
222 North 32nd St.
Billings, MT 59101
Telephone: (406) 656-6399
Fax: (406) 656-6398

STARTED	11/3/99	FINISHED	11/9/99
DRILL CO.	RB&G Eng.	DRILL RIG	CME-55
DRILLER	BH	ASST DRILLER	
LOGGED BY	JM	APPROVED BY	JTS

Project No. 8M087.155

LOG OF DRILLHOLE NO. DH99-7

Sheet 6 of 6

CLIENT
Montana Dept of Natural Resources and Conservation

ARCHITECT/ENGINEER
HKM Engineering Inc.

SITE
Bair Reservoir, Montana

PROJECT
Bair Dam

(continued)

	GRAPHIC LOG	DEPTH (FT.)	Core Run (#)	Recovery	R.Q.D. %	Weathering Index	Strength Index	Permeability (ft/yr)	Point Load Index	Unit Weight (pcf)	ADDITIONAL DATA/REMARKS
			13	4/4	92	F	II,III		185.81	159.4	Slake Durability=99.2%
			14	0.2/0.2	NA	F	III				
			15	0.7/0.8	0	F	II				
		85									Run Number:16 M.C.=0.3%
86.8		5233.6	16	5.1/5	75	F	II		103.72	159.1	
											Run Number:17 M.C.=0.1% Slake Durability=99.2%
89.8		5230.6	17	5.1/5	88	F	II		126.21	181.2	
		90									
		95									
			18	5.5/5.5	73	F	I,II		11.07		
98.6		5221.8									

Dolomitic Limestone/Marble; gray, strong to very strong, granular, fine grained grading to aphanitic, numerous healed fractures

Dolomitic Marble; phenocrysts 1-2mm of calcite (white) with dark gray to black limestone in matrix, very fine grained to aphanitic texture


NOTE: Inclinator installed in hole using standard Sinco 1.9" casing. Casing set with cement and bentonite.

Bottom of Hole at 98.6 ft.

HKM
Engineering

HKM Engineering Inc.
222 North 32nd St.
Billings, MT 59101
Telephone: (406) 656-6399
Fax: (406) 656-6398

STARTED	11/3/99	FINISHED	11/9/99
DRILL CO. RB&G Eng.		DRILL RIG	CME-55
DRILLER	BH	ASST DRILLER	
LOGGED BY	JM	APPROVED BY	JTS

Project No. 8M087.163		LOG OF DRILLHOLE NO. DH-8				Sheet 1 of 3				
CLIENT Department of Natural Resources and Conservation					ENGINEER HKM Engineering Inc.					
SITE Checkerboard, Montana					PROJECT Bair Dam					
					SAMPLES		TESTS		WELL	
					TYPE	Blows Per 6"	NUMBER	IN. RECOVERED IN. DRIVEN	N VALUE BLOWS/FOOT 10 20 30 40	PID READING (ppm) 1 10 100 1000
Surface Elev.: TBD Datum: MSL					GRAPHIC LOG	DEPTH (FT.)				
Colluvial Soils with Broken Rock Fragments; medium dense to dense, dry to slightly moist					5 10 15 20 25 30 35 40 45 50					Drill Cuttings and Bentonite
26.0 Meta-Sedimentary Bedrock; Crystalline Limestone, Siliceous Shale, and Marble, fractured, olive to dark green and white, becoming less fractured with depth, (material difficult to classify due to nature of air rotary drilling methods)										
Continued Next Page										
		HKM Engineering Inc. 222 North 32nd St. Billings, MT 59101 Telephone: (406) 656-6399 Fax: (406) 656-6398			STARTED	3/26/02	FINISHED	3/27/02		
					DRILL CO.	O'Keefe	DRILL RIG	Reich		
					DRILLER	DD, SM	ASST DRILLER			
					LOGGED BY	JLG	APPROVED			

WELL LOG BAIRDAM.GPJ MSE HKM.GDT 11/18/03

PROJECT **Bair Dam**

Continued Next Page

STARTED	3/26/02	FINISHED	3/27/02
DRILL CO.	O'Keefe	DRILL RIG	Reich
DRILLER	DD,SM	ASST DRILLER	
LOGGED BY	JLG	APPROVED	

Project No. 8M087.163

LOG OF DRILLHOLE NO. DH-8

Sheet 3 of 3

CLIENT

Department of Natural Resources and Conservation

ENGINEER

HKM Engineering Inc.

SITE

Checkerboard, Montana

PROJECT

Bair Dam

(continued)

GRAPHIC LOG

DEPTH (FT.)

TYPE

Blows Per 6"

NUMBER

IN. RECOVERED
IN. DRIVENPID READING (ppm)
1 10 100 1000TESTS
N VALUE
BLOWS/FOOT
10 20 30 40WELL
CONSTRUCTION

146.0

Bottom of Hole at 146 ft

1/16"
Perforated
CasingSilica Sand
Filter Pack**HKM**
EngineeringHKM Engineering Inc.
222 North 32nd St.
Billings, MT 59101
Telephone: (406) 656-6399
Fax: (406) 656-6398

STARTED	3/26/02	FINISHED	3/27/02
DRILL CO.	O'Keefe	DRILL RIG	Reich
DRILLER	DD,SM	ASST DRILLER	
LOGGED BY	JLG	APPROVED	

Project No. 8M087.163		LOG OF DRILLHOLE NO. DH-9				Sheet 1 of 2																
CLIENT Department of Natural Resources and Conservation					ENGINEER HKM Engineering Inc.																	
SITE Checkerboard, Montana					PROJECT Bair Dam																	
					SAMPLES		TESTS		WELL													
					DEPTH (FT.)	TYPE	Blows Per 6"	NUMBER	IN. RECOVERED IN. DRIVEN	N VALUE BLOWS/FOOT		WELL CONSTRUCTION										
										10	20		30	40								
Surface Elev.: TBD Datum: MSL							PID READING (ppm)															
							1	10	100	1000												
Colluvial Soils with Broken Rock Fragments; medium dense to dense, dry to slightly moist					GRAPHIC LOG		DEPTH (FT.)		TYPE		Blows Per 6"		NUMBER		IN. RECOVERED IN. DRIVEN		N VALUE BLOWS/FOOT		PID READING (ppm)		WELL CONSTRUCTION	

Drill Cuttings and Bentonite

 Bentonite and Cement Grout

 1.9" OD Slope Indicator Standard Casing

WELL LOG BAIRDAM.GPJ MSE HKM.GDT 11/18/03

Project No. 8M087.163

LOG OF DRILLHOLE NO. DH-10

Sheet 1 of 2

CLIENT

Department of Natural Resources and Conservation

ENGINEER

HKM Engineering Inc.

SITE

Checkerboard, Montana

PROJECT

Bair Dam

Surface Elev.: **TBD** Datum: **MSL**

Colluvial Soils with Broken Rock Fragments; medium dense to dense, dry to slightly moist

23.0

Meta-Sedimentary Bedrock; Crystalline Limestone, Siliceous Shale, and Marble, fractured, green to gray

Continued Next Page

HKM
EngineeringHKM Engineering Inc.
222 North 32nd St.
Billings, MT 59101
Telephone: (406) 656-6399
Fax: (406) 656-6398

STARTED	6/27/02	FINISHED	6/27/02
DRILL CO.	O'Keefe	DRILL RIG	Reich
DRILLER	DD,SM	ASST DRILLER	
LOGGED BY	JLG	APPROVED	

Project No. 8M087.163

LOG OF DRILLHOLE NO. DH-10

Sheet 2 of 2

CLIENT

Department of Natural Resources and Conservation

ENGINEER

HKM Engineering Inc.

SITE

Checkerboard, Montana

PROJECT

Bair Dam

(continued)

GRAPHIC LOG

DEPTH (FT.)

TYPE

Blows Per 6"

NUMBER

IN. RECOVERED
IN. DRIVEN

SAMPLES

TESTS

N VALUE
BLOWS/FOOT

10 20 30 40

PID READING (ppm)

1 10 100 1000

WELL

WELL
CONSTRUCTION

72.0

1/16"
Perforated
Casing
Silica Sand
Filter Pack

Bottom of Hole at 72 ft.

HKM
EngineeringHKM Engineering Inc.
222 North 32nd St.
Billings, MT 59101
Telephone: (406) 656-6399
Fax: (406) 656-6398

STARTED	6/27/02	FINISHED	6/27/02
DRILL CO.	O'Keefe	DRILL RIG	Reich
DRILLER	DD,SM	ASST DRILLER	
LOGGED BY	JLG	APPROVED	

WELL LOG BAIRDAM.GPJ MSE HKM.GDT 11/18/03

APPENDIX E

TEST PIT LOGS

Note: Test pits TP99-1 and TP99-2 were excavated along the southwest shore of the lake. Test pits TP99-3 and TP99-4 were excavated in the original borrow area used during construction of the dam south of Highway 12. See Figure 6-2 in the Bair Dam Rehabilitation Feasibility Study Report, dated October 1, 2000, for location of the test pits.

Test Pit Logs:

Bair Dam

Montana Department of Natural Resources and Conservation

Test Pit TP-1:

Approximate Surface Elevation 5309 (ft)

- 0.0 – 3.5 ft. Sandy Gravel (GP); loose to compact, brown, little silt, occasional cobbles, max size 12", gravels are sub-rounded.
- 3.5 – 10.0 ft. Sand and Gravel (GP); compact, grayish brown, little to some silt, gravel size particles are angular broken pieces of bedrock, material is shale like, no groundwater encountered.

Test Pit TP-2:

Approximate Surface Elevation 5306 (ft)

- 0.0 – 1.0 ft. Topsoil
- 1.0 – 4.5 ft. Gravelly Clay (CL-ML); firm, moderate brown, (fill?)
- 4.5 – 10.0 ft. Gravelly Clayey Silt (ML); firm, brown, water at 9.5 ft.

Test Pit TP-3:

Approximate Surface Elevation 5480 (ft)

- 0.0 – 5.0 ft. Silty Clay (CL); firm, weathered, brown-gray, (weathered bedrock?)
- 5.0 – 9.0 ft. Silty Clay (CL); firm/hard, reddish brown, vari-colored angular fragments (Shale) in silty clay matrix (Colluvium?)
- 9.0 – 10.0 ft. Becomes brownish gray with cobbles, 8" max size, moist

Test Pit TP-4:

Approximate Surface Elevation 5490 (ft)

- 0.0 – 0.5 ft. Topsoil
- 0.5 – 5.0 ft. Silty Clay (CL); firm/hard, mottled red, brown/gray, occasional cobble size clast, dry to slightly moist
- 5.0 – 10.0 ft. Silty Clay (CL); firm, reddish brown, (weathered bedrock?), becoming damp

APPENDIX F

SPILLWAY EXTENDED WARRANTY

BAIR DAM REHABILITATION PROJECT—PHASE II
CONTRACT MODIFICATION—EXTENDED WARRANTY

This document modifies the Agreement dated April 29, 2002 between the Montana Department of Natural Resources and Conservation (DNRC) and Dick Anderson Construction, Inc. (DAC) for Phase II of the Bair Dam Rehabilitation Project.

The placement of the ogee concrete by DAC did not meet line and grade tolerance requirements. DAC was allowed to remove and replace concrete in two limited areas of the crest, rather than a more extensive repair, on the condition that DAC would warrant the durability of the concrete repairs for an extended period. DAC completed the limited repairs on December 19, 2002. Subsequent to completion of those limited repairs, the ogee crest was inspected yet again and found to require additional limited repair. DAC completed those repairs on June 13, 2003.

DAC warrants the repair concrete and the repair joints against deterioration in excess of that of the surrounding concrete for a period of ten years, until June 13, 2013. DAC will provide all labor and materials necessary to complete repairs acceptable to DNRC if unacceptable deterioration occurs.

The correction period provided in section 13.07 of the General Conditions in the contract documents for the concrete repairs to the spillway ogee crest is hereby extended to ten years (i.e. until June 13, 2013). Section 13.07 shall otherwise remain as stated and all other Contractor warranties and guarantees are unchanged by this modification.

APPROVED:



Date: 8-10-03

Dick Anderson Construction, Inc.
342 Highway 12 East
Helena, MT 59601



Date: 8/11/03

Montana DNRC
P.O. Box 201601
Helena, MT 59601

APPENDIX G

PROJECT DRAWINGS


NOTE: The reduced project drawings should be used for reference only. The SWPB has the full size project drawings.

Sheets 2 through 6 are design drawings and not "As Builts".

Phase 1 and Phase 2 drawings are "Record Drawing" which were taken from the draft Construction Report (October, 2003). When the Construction Report is finalized, these drawings may change. Check date on drawings.

INDEX OF DRAWINGS

Sheet		Page
2	Details Of Dam	G3
3	Plan And Profile	G5
4	Inlet Structure Of Control Works	G7
5	Control Chamber & Tower OF Control Works	G9
6	Conduit Outlet Structure & Weir OF Control Works	G11
S10	Standard Jet Pump For Sump Drainage	G13
 Phase 1 – Bair Dam Rehabilitation Project		
G1	Cover Sheet	G15
G6R	Toe Berm Area Topography	G17
D1	Drain Manhole Plan and Section	G19
S2	Outlet Works Terminal Structure Plan View	G21
 Phase 2 – Bair Dam Rehabilitation Project		
G1	Cover Sheet	G23
SC1	Principal Spillway Plan And Profile	G25
SC2	Principal Spillway Typical Sections	G27
SC5	Principal Spillway Drains Plan	G29
SC6	Principal Spillway Crest Elevation Grading Plan	G31
SS1	Principal Spillway Structure Plan And Profile	G33
SS2	Principal Spillway Structure Sections And Details	G35
SS3	Principal Spillway Structure Sections And Detail	G37
SS4	Principal Spillway Structure Stilling Basin Details	G39
GH1	Gate House Replacement	G41
GH2	Gate House Replacement Sections And Details	G43
E1	Embankment Enlargement Plan	G45
LR1	Landslide Excavation Plan	G47
LR2	Landslide Area Cross Sections A and B	G49
LR3	Landslide Area Cross Section C	G51

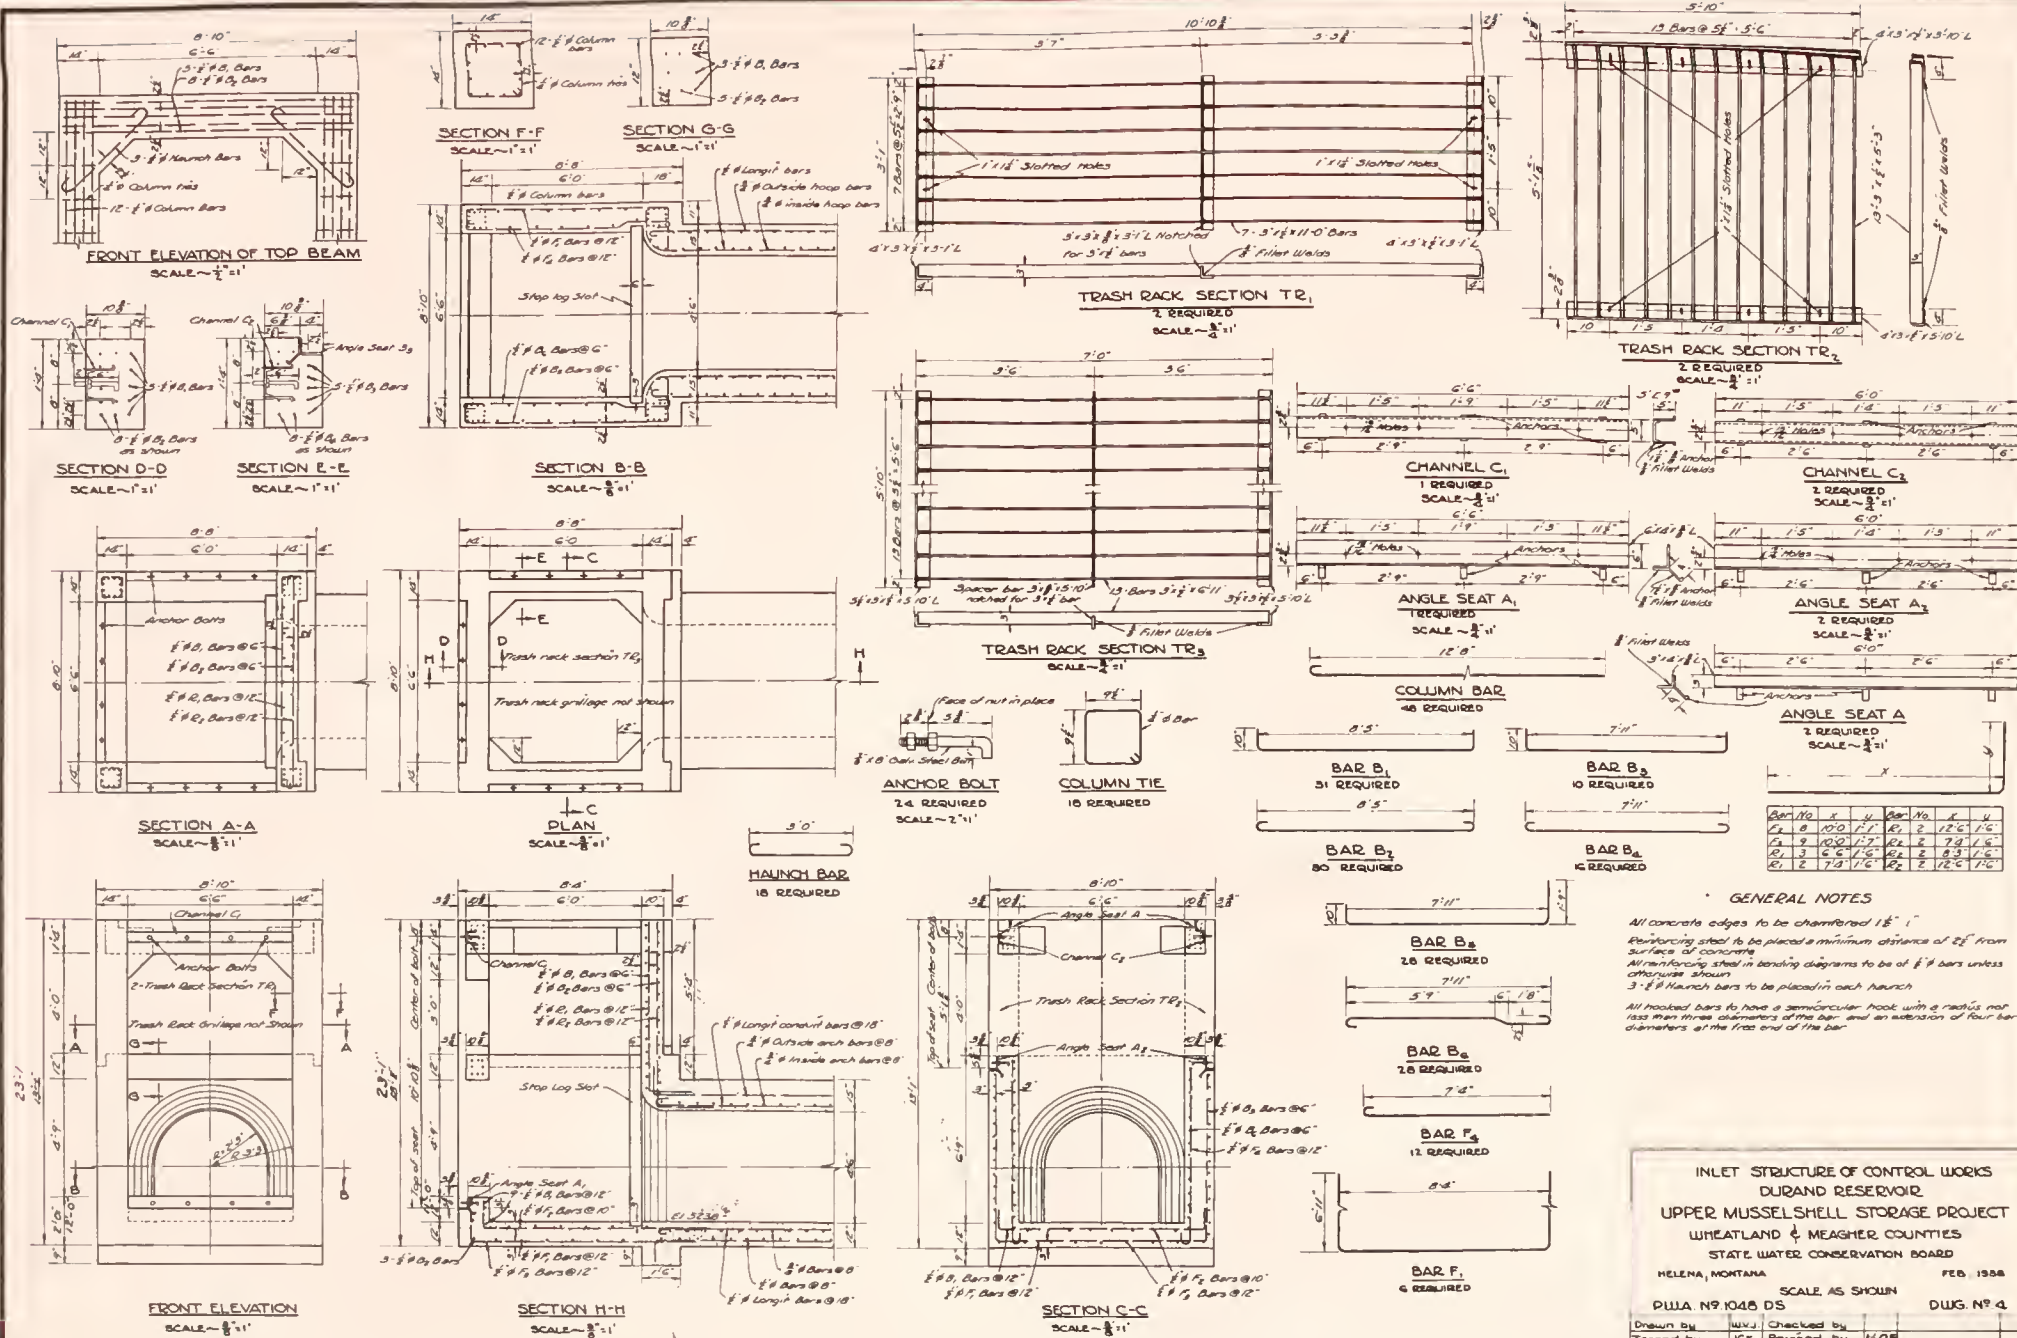


GENERAL NOTES

All concrete edges to be chamfered 1/8" from surface of concrete.

All reinforcing steel in bending diagrams to be of #4 bars unless otherwise shown.

3 #4 haunch bars to be placed in each haunch.

All hooked bars to have a semi-circular hook with a radius not less than three diameters of the bar and an extension of four bar diameters at the free end of the bar.


**INLET STRUCTURE OF CONTROL WORKS
DURAND RESERVOIR
UPPER MUSSEL SHELL STORAGE PROJECT
WHEATLAND & MEAGHER COUNTIES
STATE WATER CONSERVATION BOARD**


SCALE AS SHOWN












DRAWN BY W.V.J. CHECKED BY W.V.J.
TRACED BY J.C.K. REVISED BY H.O.E.

PULLA N9.1045 DS DWG. NO. 4

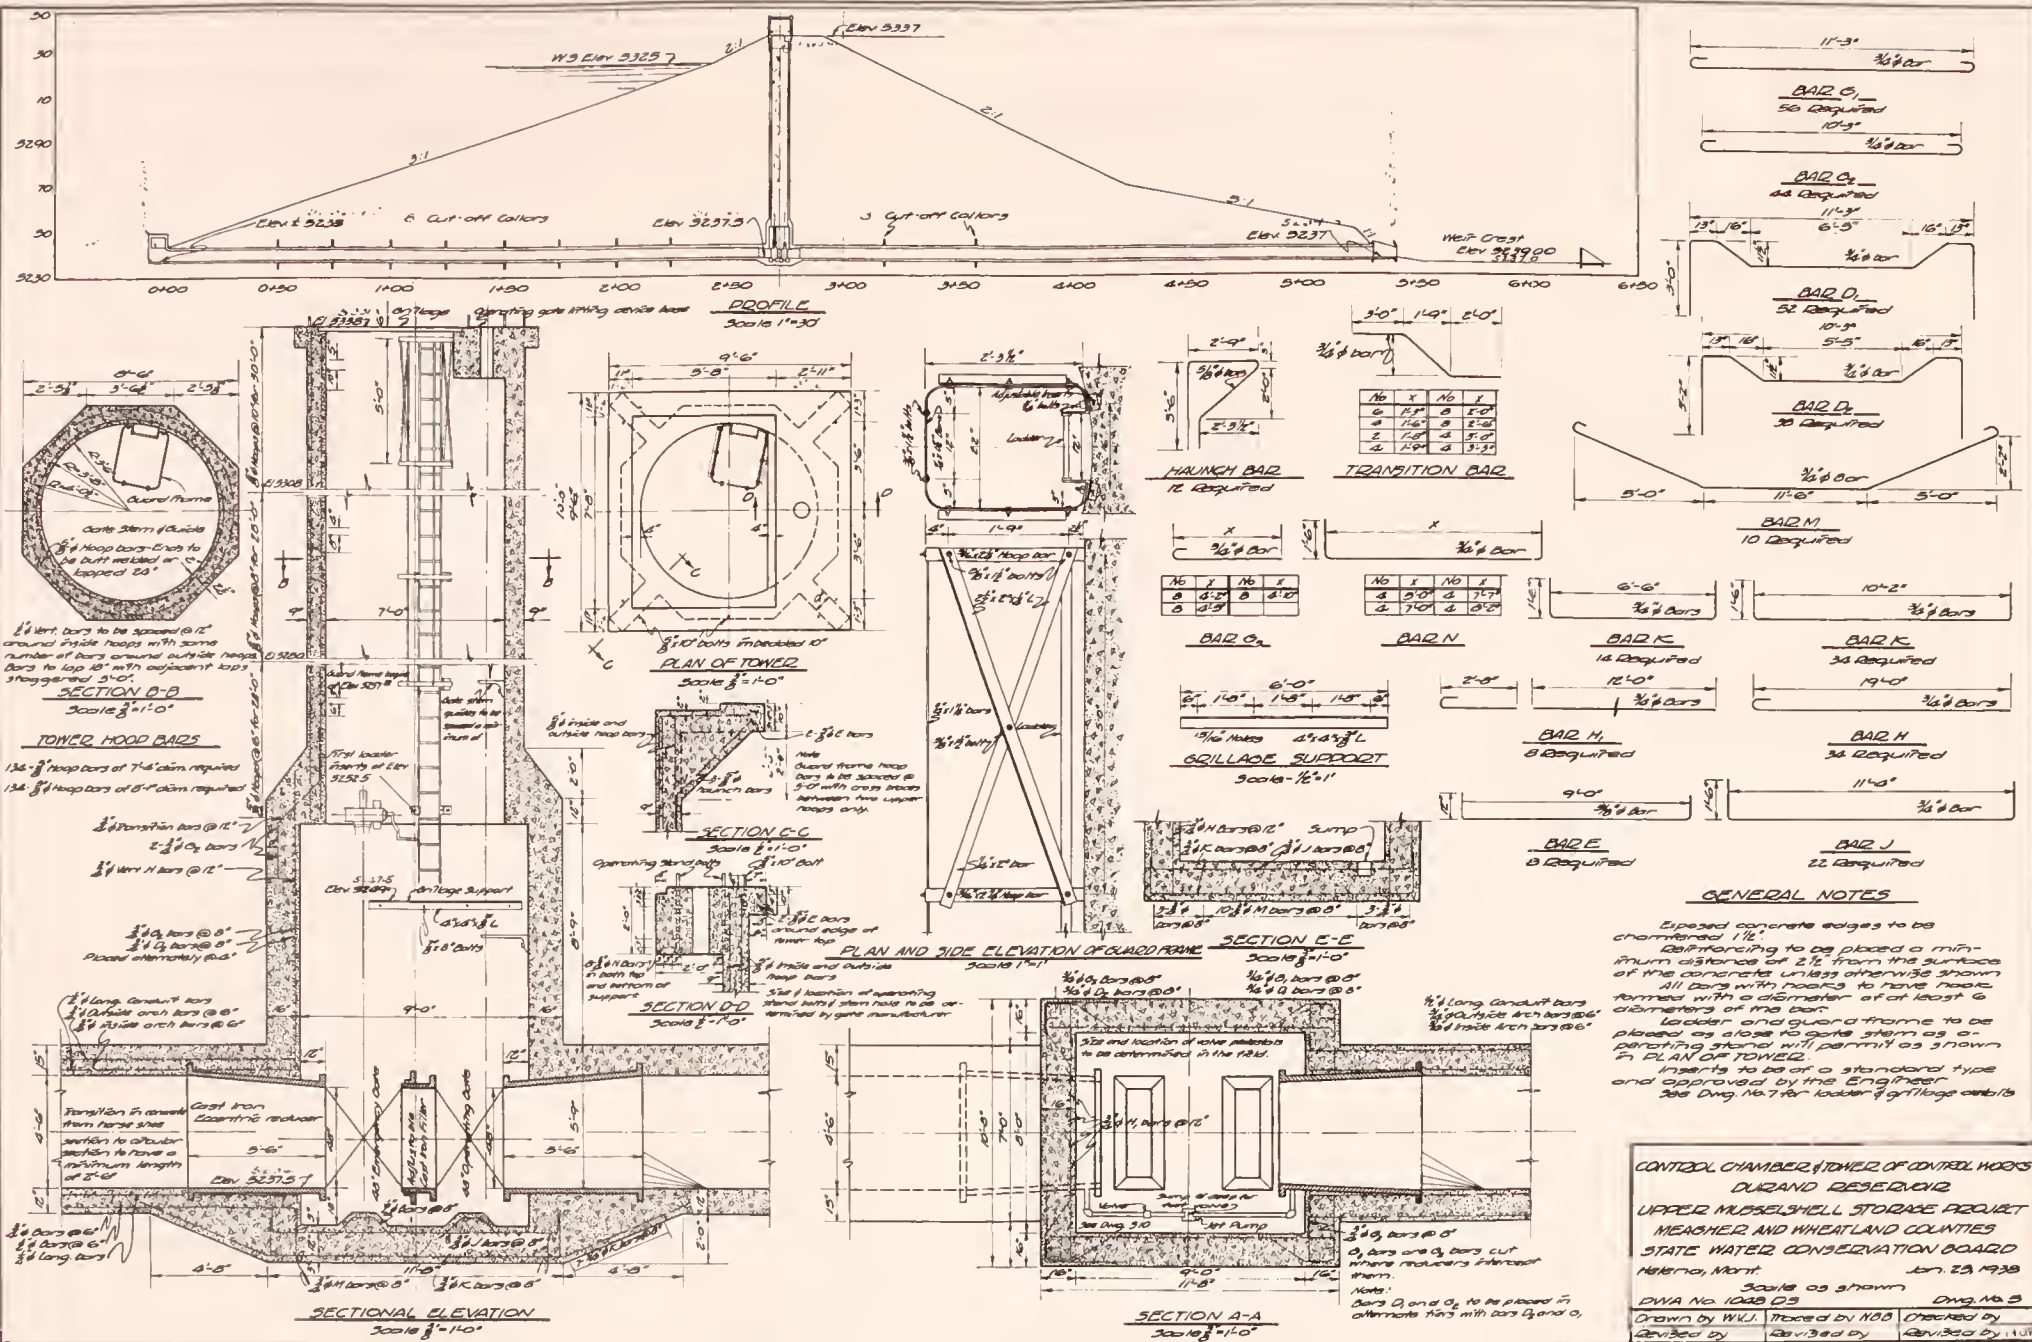

CONTROL CHAMBER & TOWER OF CONTROL WORKS
DURAND RESERVOIR

Scale as shown
DWA No. 1008 DS Dwg. No. 3
Drawn by W.K.L. Checked by H.B.B. Checked by J.W.L.
Revised by

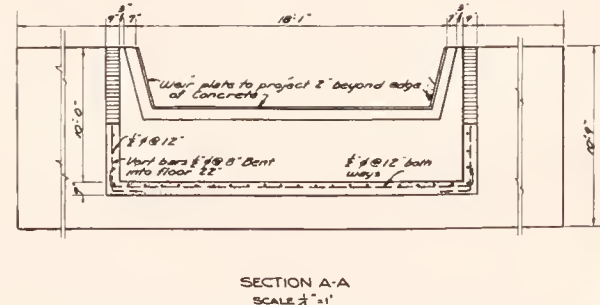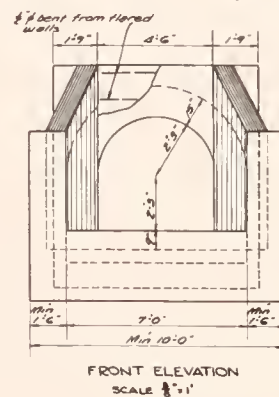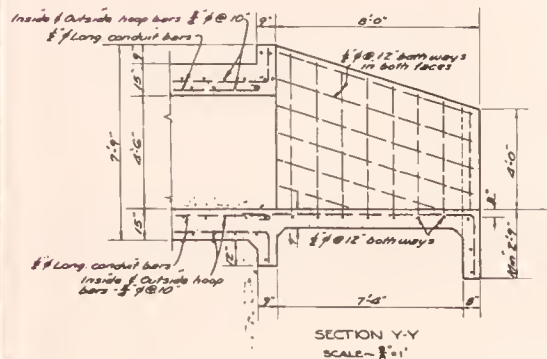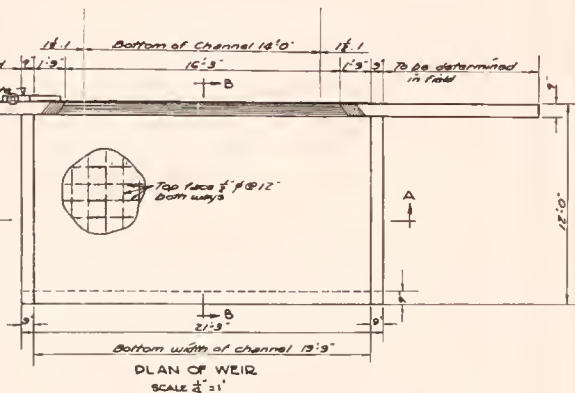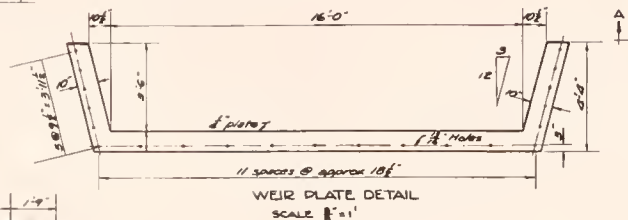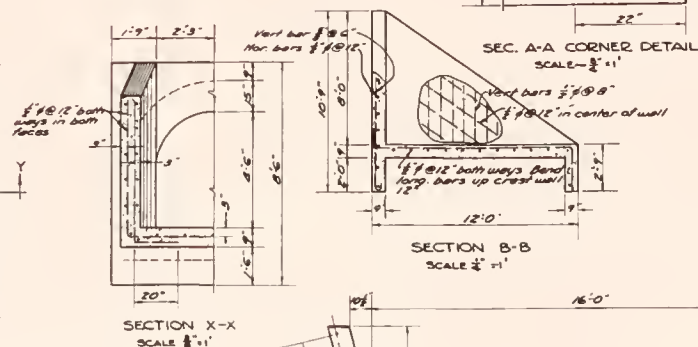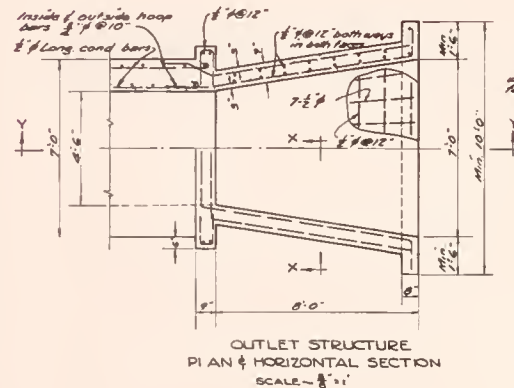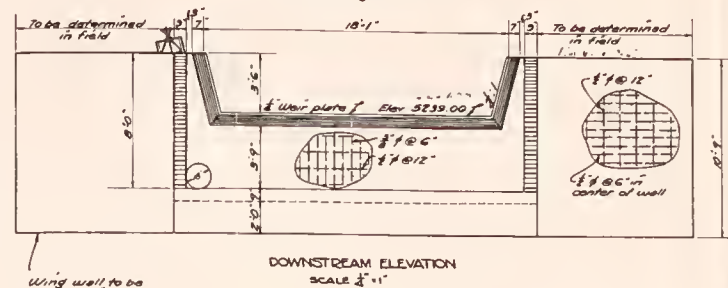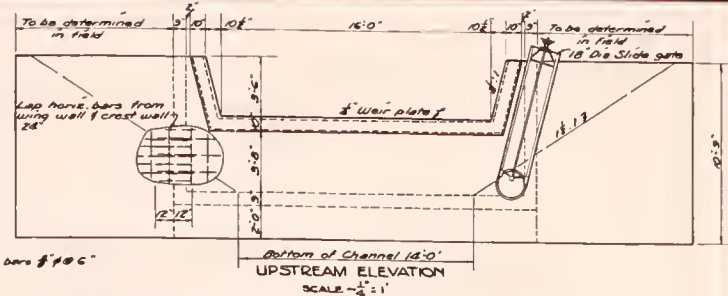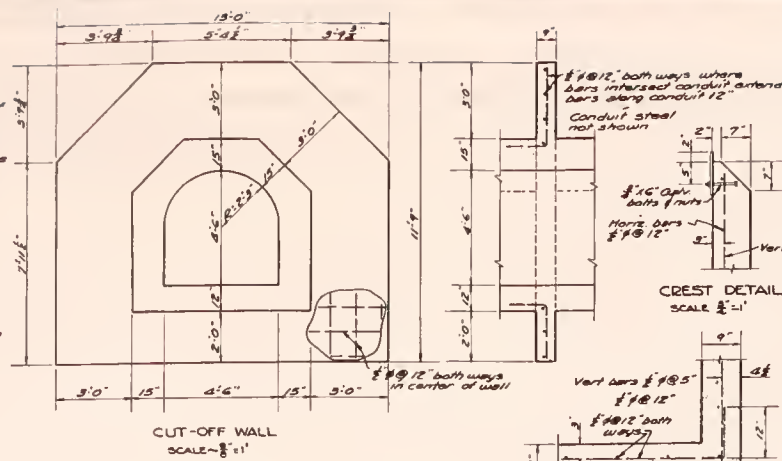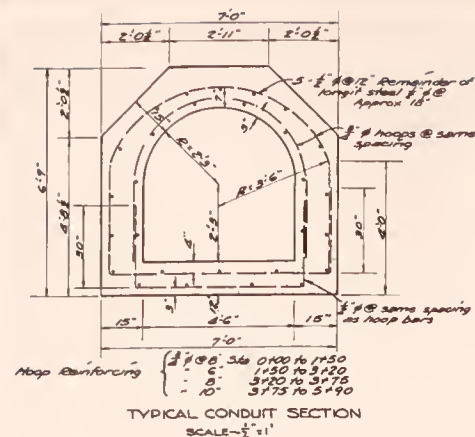

GENERAL NOTES

Chamfer all exposed edges of concrete 1"
Minimum distance between face of concrete
and reinforcing steel to be 2 1/2"

CONDUIT OUTLET STRUCTURE & WEIR OF CONTROL WORKS DURAND RESERVOIR

UPPER MUSSELSHELL STORAGE PROJECT
WHEATLAND & MEAGHER COUNTIES


STATE WATER CONSERVATION BOARD
MONTANA, FEB.

SCALE AS SHOWN


PULA NO. 1048 DS

DRAWING NO. 6


Drawn by	SYW	Checked by	
Traced by	UCK	Revised by	H/Z

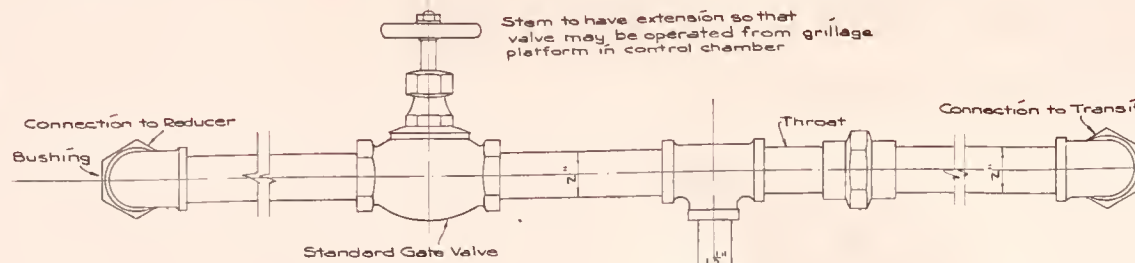


Note:
Pipe and all fittings to be extra strong galvanized.
Sump to be located in chamber as directed by the engineer.

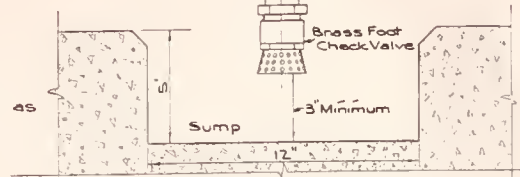

ELEVATION
SCALE $\sim \frac{1}{4}'' = 1''$

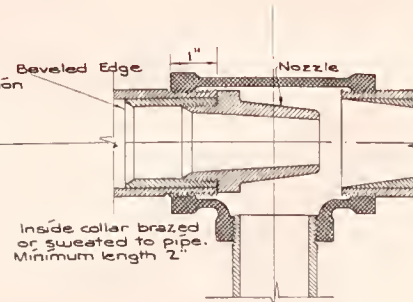


SECTION THROUGH TEE
SCALE $\sim \frac{1}{2}'' = 1''$


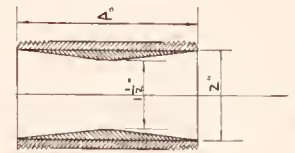


Throat to be made by filling with brazing metal

SECTION THROUGH THROAT
SCALE $\sim \frac{1}{2}'' = 1''$

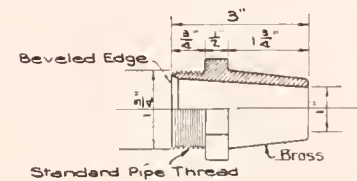

NOZZLE DETAIL
SCALE $\sim \frac{1}{2}'' = 1''$

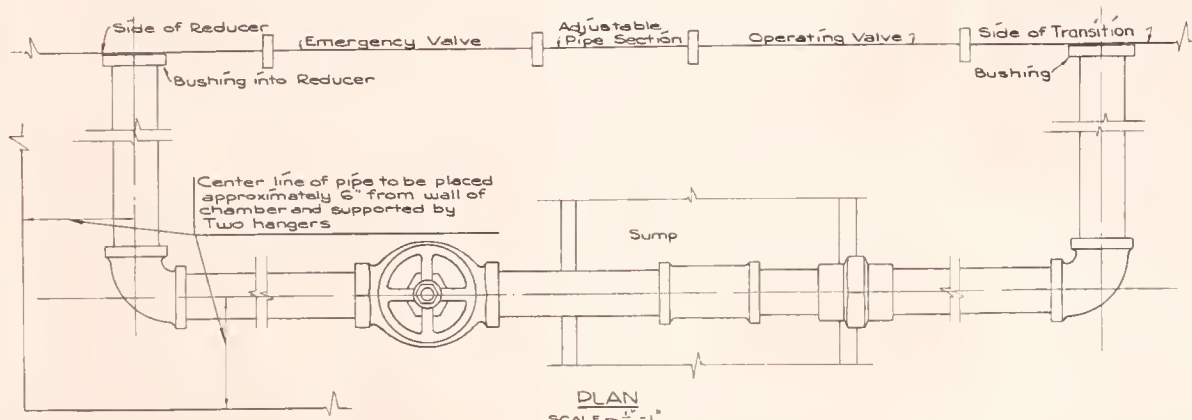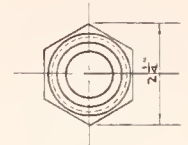

PLAN
SCALE $\sim \frac{1}{4}'' = 1''$

STANDARD JET PUMP

FOR SUMP DRAINAGE

STATE WATER CONSERVATION BOARD

HELENA, MONTANA

OCT. 31, 1935


SCALE AS SHOWN

DWG. S-10


Drawn by	WVJ	Checked by	GFS.		
Traced by	JCK				

BAIR DAM REHABILITATION PROJECT - PHASE 1

MEAGHER COUNTY, MONTANA

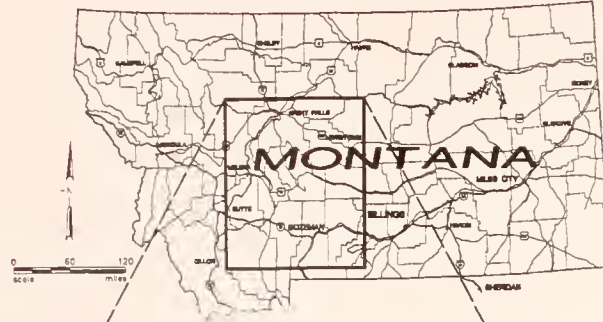

PROJECT LOCATION MAP

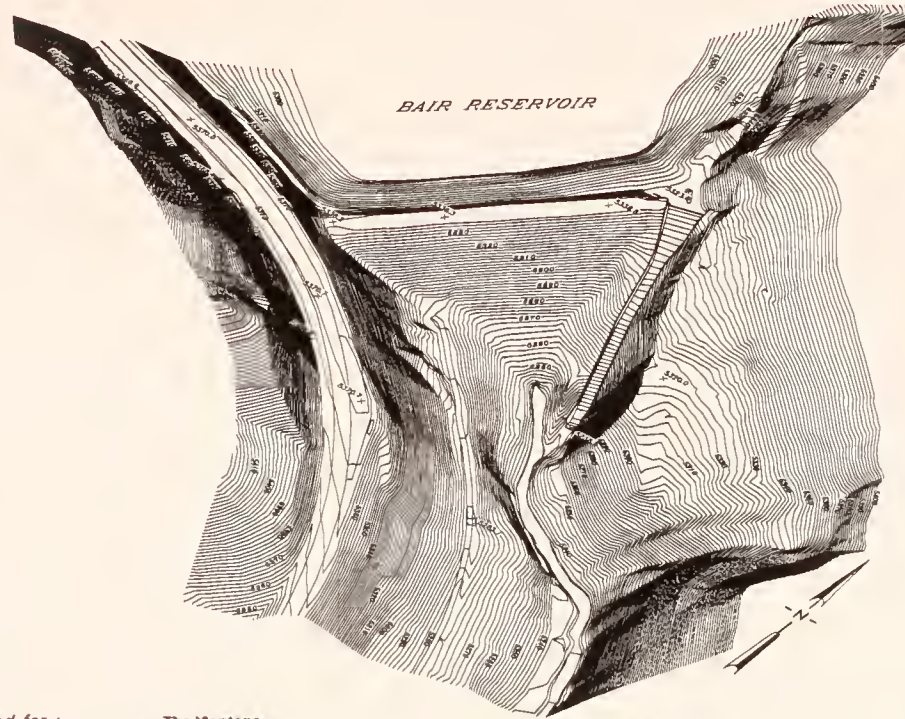

PERSPECTIVE VIEW

Prepared for :

The Montana
Department of Natural Resources
and Conservation



State Water Projects Bureau
P.O. Box 201601
Helena, MT 59620-1601
(406) 444-6646

Approved: Kevin B. Smith, P.E., Acting Chief
State Water Projects Bureau, Montana DNRC



Jason H. Thom, P.E. 6396 E
Project Engineer
HKM Engineering, Inc.

SHEET INDEX

SHT. NO.	DESCRIPTION
G1	COVER SHEET
G2	GENERAL SITE PLAN AND SURVEY CONTROL
G3	GENERAL SITE PLAN AND PROPOSED FEATURES
G3R	GENERAL SITE POST PHASE 1 CONSTRUCTION TOPOGRAPHY
G4	SPILLWAY GRADING PLAN
G4R	PRINCIPAL SPILLWAY AREA POST PHASE 1 CONSTRUCTION TOPOGRAPHY
G5	TYPICAL SPILLWAY SECTIONS AND ACCESS ROAD PROFILE
G6	TOE BERM PLAN AND TYPICAL SECTION
G6R	TOE BERM AREA POST PHASE 1 CONSTRUCTION TOPOGRAPHY
D1	DRAIN MAN-HOLE PLAN AND SECTION
S1	GENERAL STRUCTURAL NOTES & STANDARD DETAILS
S2	OUTLET WORKS TERMINAL STRUCTURE PLAN VIEW, WING WALL ELEVATION & SECTIONS

Prepared by :



HKM Engineering Inc.
Granite Tower Building
222 N. 32nd St., Suite 700
P.O. Box 31318
Billings, MT 59107-1318
(406) 656-6399, FAX (406) 656-6398

Proj. No. 6M087.163

AUGUST 2001

No.	Revision	By	Date
1	REC. DWG.	SE	2/16/02

Sheet No.

G1



of 9

RECORD DRAWING
DEC. 2001




BAIR DAM REHABILITATION PROJECT - PHASE II MEAGHER COUNTY, MONTANA

RECORD DRAWINGS
JUNE 2003

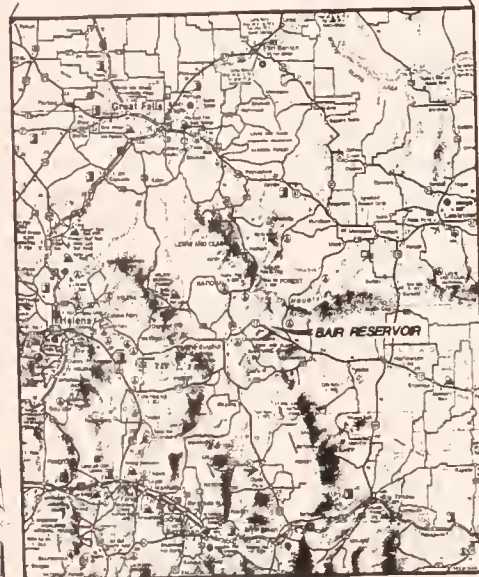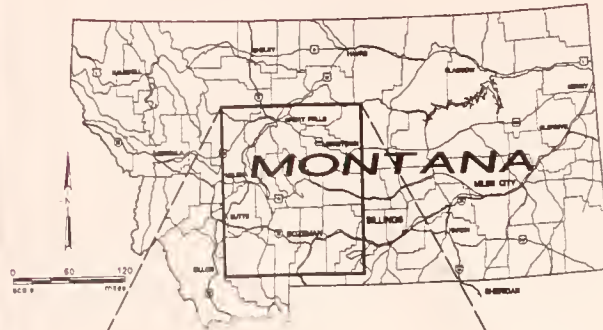

PROJECT LOCATION MAP

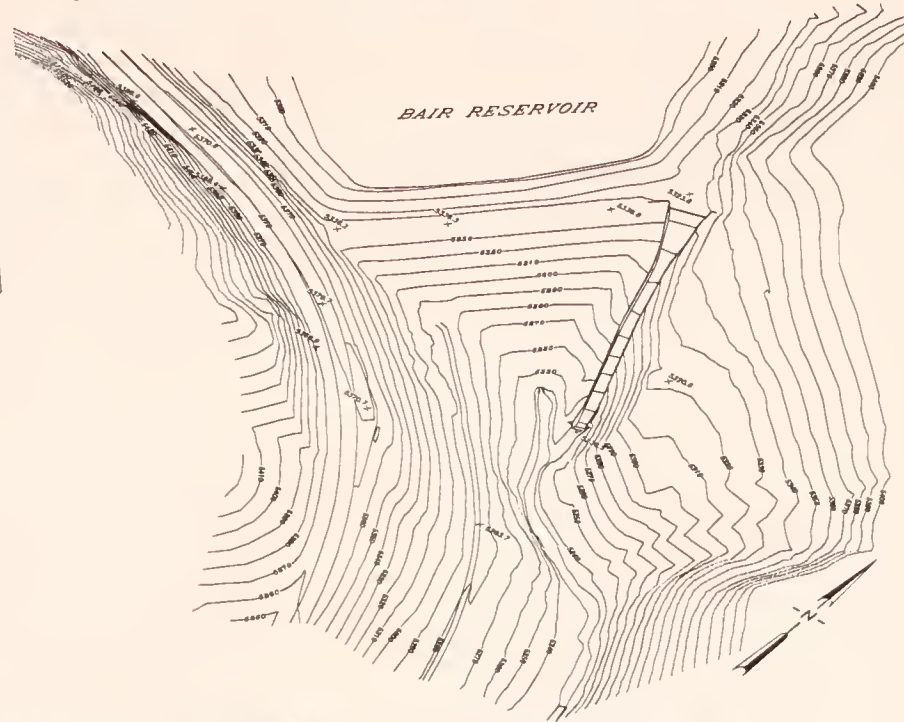

PERSPECTIVE VIEW

Prepared for :
The Montana
Department of Natural Resources
and Conservation



State Water Projects Bureau
P.O. Box 201601
Helena, MT 59620-1601
(406) 444-6646

Approved: Glen McDonald, P.E., Chief
State Water Projects Bureau, Montana DNRC



Jason H. Thom, P.E. 6398 E
Project Engineer
HKM Engineering, Inc.

SHEET INDEX

SHT. NO.	DESCRIPTION
G1	COVER SHEET
G2	GENERAL SITE PLAN
GS1	GENERAL STRUCTURAL NOTES AND DETAILS
SC1	PRINCIPAL SPILLWAY PLAN AND PROFILE
SC2	PRINCIPAL SPILLWAY TYPICAL SECTIONS
SC3	PRINCIPAL SPILLWAY CROSS SECTIONS STA. 0+00 TO STA. 3+28
SC4	PRINCIPAL SPILLWAY CROSS SECTIONS STA. 3+50 TO STA. 5+25
SC5	PRINCIPAL SPILLWAY DRAINS PLAN
SC6	PRINCIPAL SPILLWAY CREST EXCAVATION GRADING PLAN
SC7	PRINCIPAL SPILLWAY GROUT CURTAIN PLAN AND PROFILE
SS1	PRINCIPAL SPILLWAY STRUCTURE PLAN AND PROFILE
SS2	PRINCIPAL SPILLWAY STRUCTURE SECTIONS AND DETAILS (1)
SS3	PRINCIPAL SPILLWAY STRUCTURE SECTIONS AND DETAILS (2)
SS4	PRINCIPAL SPILLWAY STRUCTURE STILLING BASIN DETAILS
GH1	GATE HOUSE REPLACEMENT PLAN, ELEVATIONS, SECTIONS AND DETAILS
GH2	GATE HOUSE REPLACEMENT SECTIONS AND DETAILS
E1	EMBANKMENT ENLARGEMENT PLAN
E2	EMBANKMENT ENLARGEMENT CROSS SECTIONS STA. 0+25 TO STA. 2+25
E3	EMBANKMENT ENLARGEMENT CROSS SECTIONS STA. 2+50 TO STA. 3+75
E4	EMBANKMENT ENLARGEMENT CROSS SECTIONS STA. 4+00 TO STA. 6+00
AR1	UPSTREAM ACCESS ROAD PLAN AND SECTIONS
S1	EMBANKMENT BORROW AREA PLAN AND SECTIONS
F1	GENERAL FENCING DETAILS
LR1	LANDSLIDE EXCAVATION PLAN
LR2	LANDSLIDE AREA CROSS SECTIONS A and B
LR3	LANDSLIDE AREA CROSS SECTION C

Prepared by :



HKM Engineering Inc.
Granite Tower Building
222 N. 32nd St., Suite 700
P.O. Box 31318
Billings, MT 59107-1318
(406) 656-6399, FAX (406) 656-6398



Proj. No. 8M087.163

FEBRUARY 2002

Sheet No.

G1

of 23

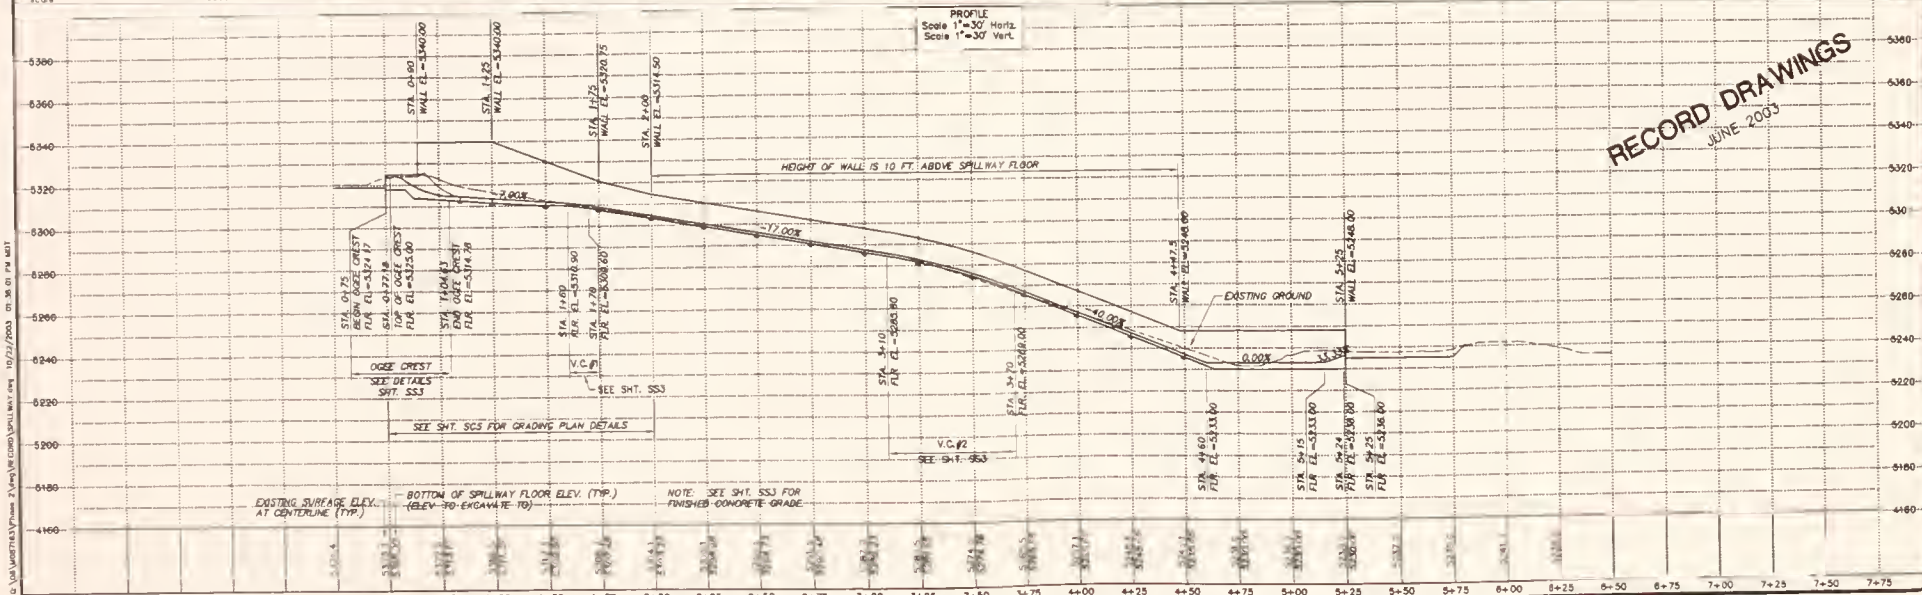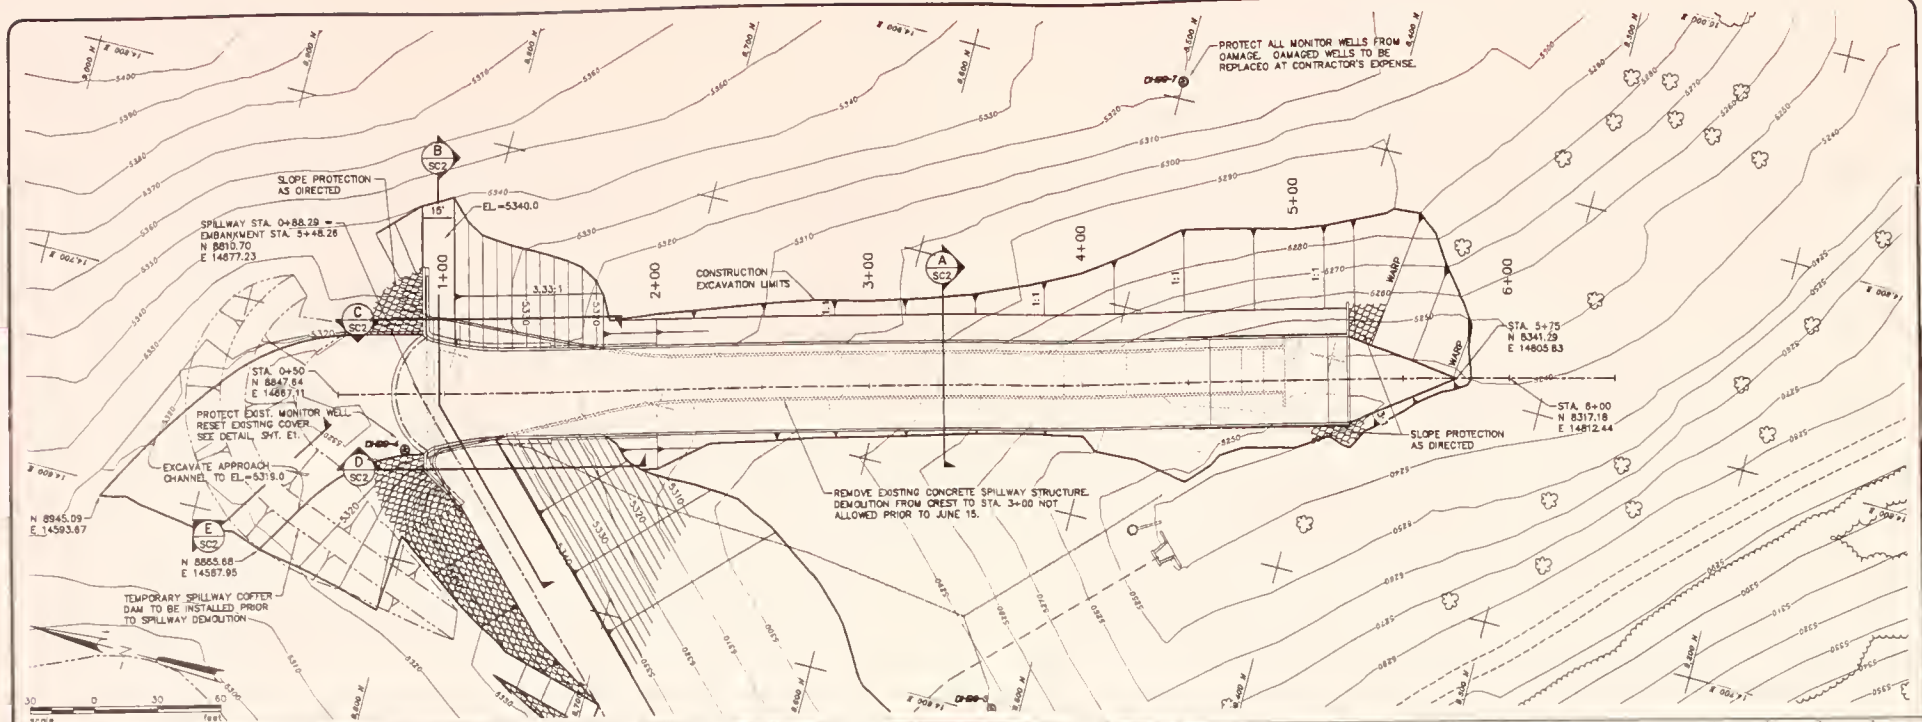

RECORD DRAWINGS
JUNE 2003

Project No. 66087163 • SPM MAY 2002 • Date FEB 2003 • Designed JHT • Checked JHT • Approved JHT

Revision By Date
Record Draw JHT 6/03

WARNING
THIS DRAWING IS NOT TO BE USED FOR CONSTRUCTION WITHOUT THE SIGNATURE OF THE DESIGNER.

BAR DAM REHABILITATION - PHASE II
MEAGER COUNTY, MONTANA
PRINCIPAL SPILLWAY
PLAN AND PROFILE


HKM Engineering Inc.
Granite Tower Building
222 N. 32nd St., Suite 700
P.O. Box 31318
Billings, MT 59107-1318
(406) 656-6399 FAX (406) 656-6398

HKM
ENGINEERING

Sheet No.
SC1
of 23

LEGEND

- 2" FLOOR DRAIN
- 6" FLOOR DRAIN
- 6" WALL DRAIN
- CLEAN OUT
- END CAP (TYP.)

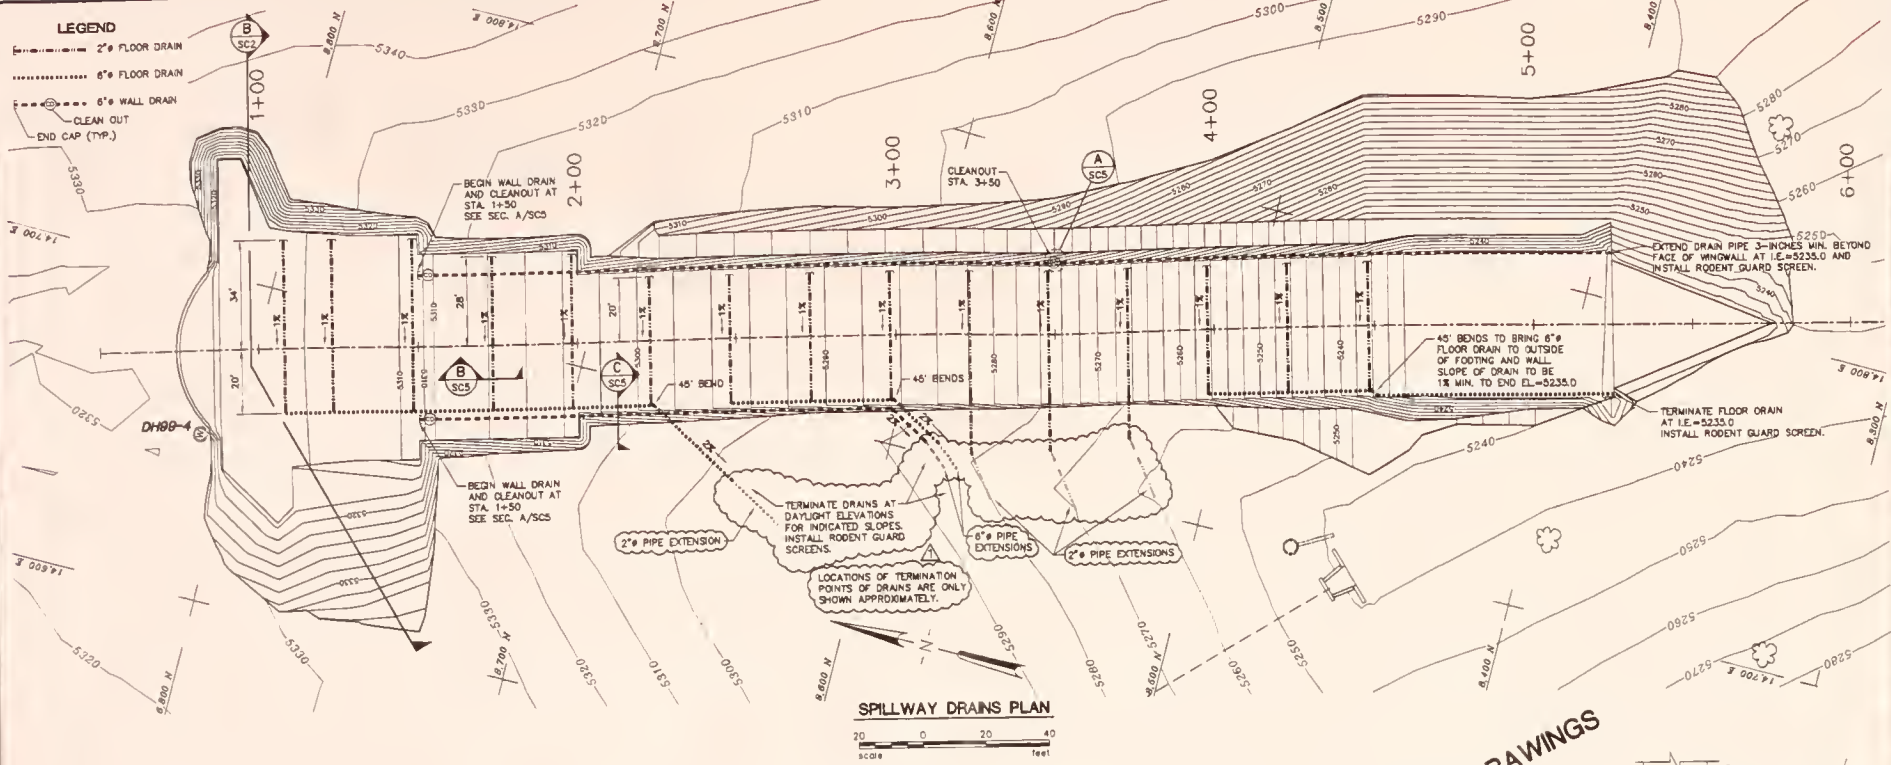


SPILLWAY DRAINS PLAN


20 0 20 40
feet

RECORD DRAWINGS
JUNE 2003

INSTALL STEEL WATER-TIGHT FLUSH-MOUNT 8"x12" WELL MANHOLE OVER CLEANOUT TO PROVIDE PROTECTION AND FUTURE ACCESS.

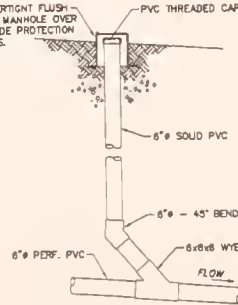


A DETAIL
SC5 WALL DRAIN CLEANOUT
NO SCALE

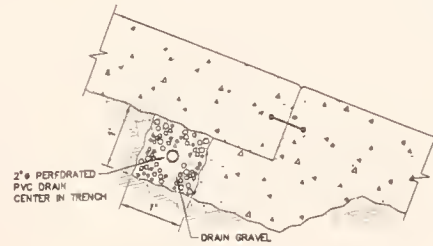

B SECTION
SC5 FLOOR DRAIN AT JOINT
1 0 1 2
feet

NOTE: ALL DRAIN PIPE TO BE NEW, PERFORATED RIGID POLYVINYL CHLORIDE (PVC) PIPE, SCHEDULE 80 CONFORMING TO ASTM D1785. ALL JOINTS TO BE GULDED. PERFORATIONS TO BE THREE LONGITUDINAL ROWS OF 1/4-INCH HOLES SPACED EVERY 2 INCHES. EQUIVALENT SLOTTED PIPE MAY BE SUBSTITUTED.

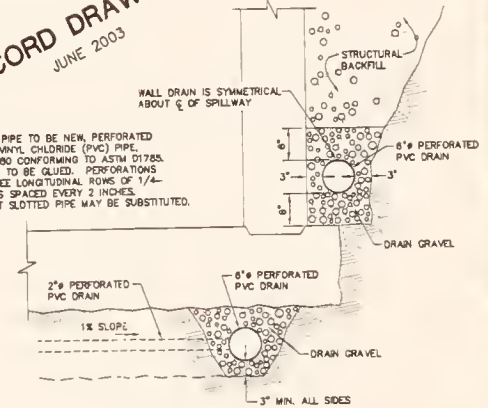

C SECTION
SC5 FLOOR & WALL DRAIN
1 0 1 2
feet

No.	Revision	By	Date
1	Record Draw	JAT	6/03

WARNING: IF THIS DRAWING IS USED FOR CONSTRUCTION, THE USER ASSUMES ALL RESPONSIBILITY FOR THE ACCURACY OF THE INFORMATION AND NOT FOR SCALE.

Project No. BA0027.63 • 3/4" = 1'-0" DRAWING • Date: FEB 2002 • Drawn: CAC • Checked: JAT • Approved: JAT

BAR DAM REHABILITATION - PHASE II
MEAGHER COUNTY, MONTANA
PRINCIPAL SPILLWAY
DRAINS PLAN





HKM Engineering Inc.
Granite Tower Building
222 N. 32nd St., Suite 700
P.O. Box 31318
Billings, MT 59107-1318
(406) 656-6397, FAX (406) 656-6398



Sheet No.
SC5
of 23

© 2003 HMM Engineering, Inc. All rights reserved. 10/21/2003 08:56:00 AM M07

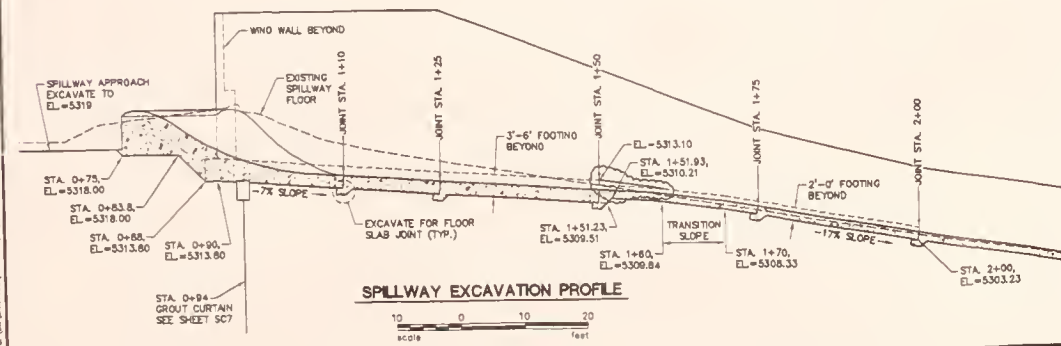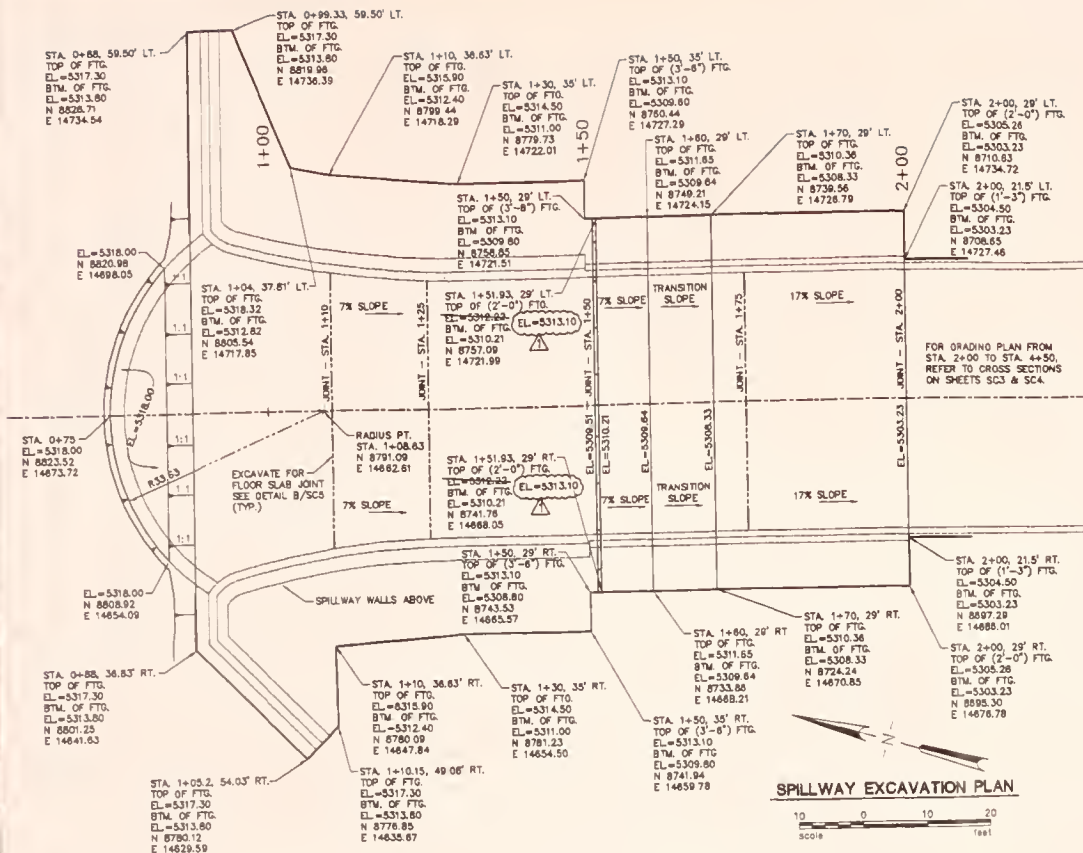

RECORD DRAWINGS
JUNE 2003

Project No. 00007.15.3 • 3W-ENCLOSURE • Date FEB. 2002 • Drawn GAC • Checked JHT • Approved JHT

Revision By Date





No.	Revision	By	Date
1	Record	JHT	5/03

BAR DAM REHABILITATION - PHASE II
MEAGER COUNTY, MONTANA
PRINCIPAL SPILLWAY
CREST EXCAVATION GRADING PLAN




HMM Engineering Inc.
Granite Tower Building
222 N. 32nd St., Suite 700
P.O. Box 31318
Billings, MT 59107-1318
(406) 656-6399; FAX (406) 656-6398

SC6

of 23

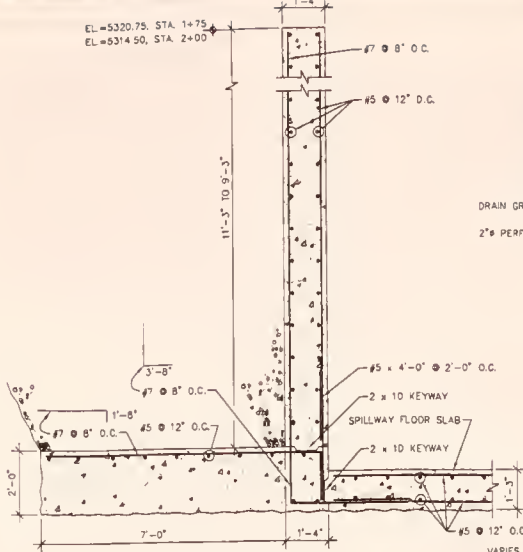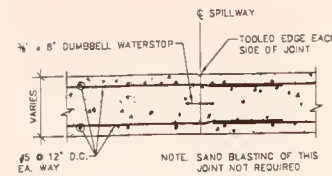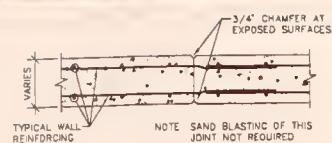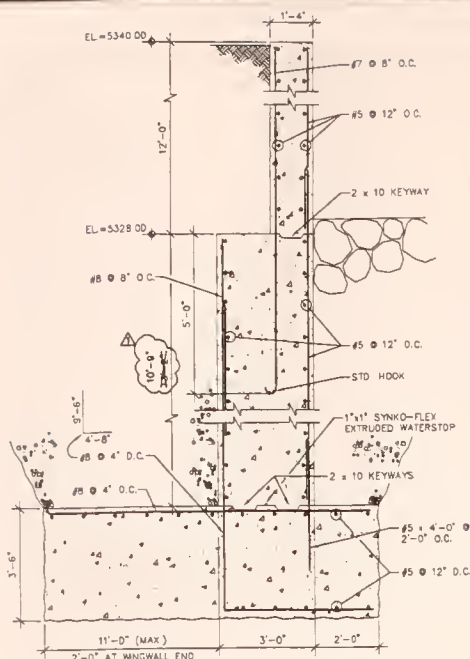

RECORD DRAWINGS
JUNE 2003

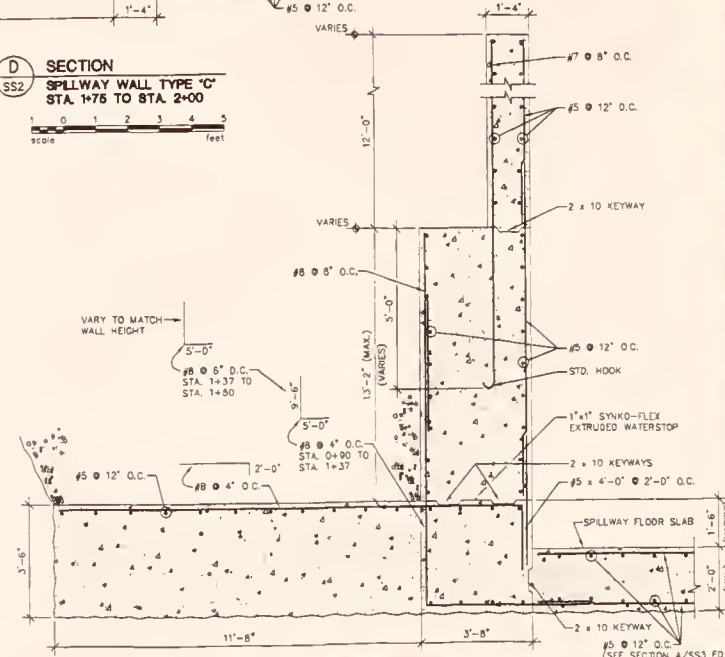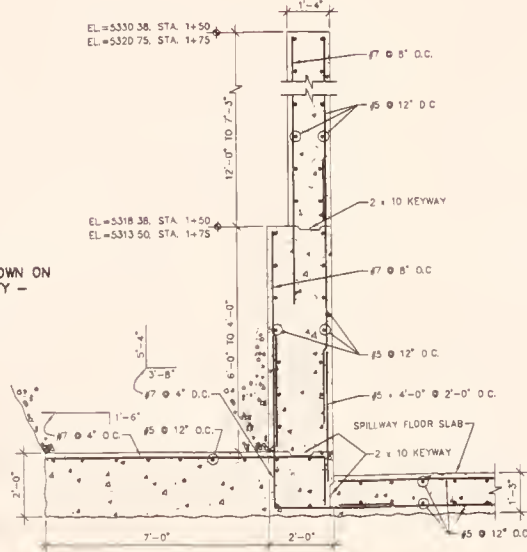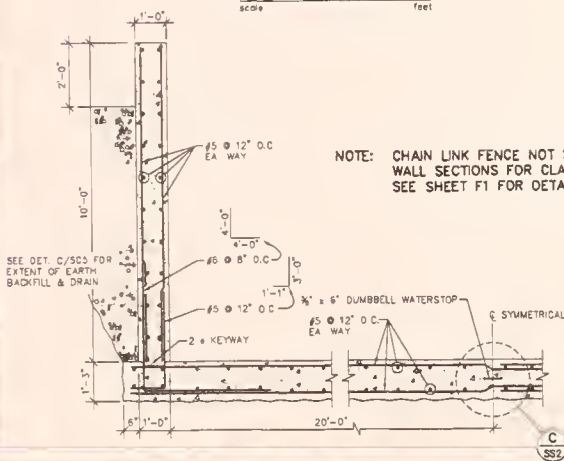

NOTE: CHAIN LINK FENCE NOT SHOWN ON WALL SECTIONS FOR CLARITY - SEE SHEET F1 FOR DETAILS

BAIR DAM REHABILITATION - PHASE II
MEAGER COUNTY, MONTANA

PRINCIPAL SPILLWAY STRUCTURE
SECTIONS AND DETAILS 10

Project No. 04067-103-00-5-SPILLWAY DMS Date FEB. 2002 Checked CHS Approved JHT

Revision No. 1
By JHT
Date 3/9/02
Description of Change
Record Draw JHT

WARNING: THESE DRAWINGS ARE NOT TO BE USED FOR CONSTRUCTION WITHOUT THE SIGNATURE OF THE DESIGNER.

HMM Engineering, Inc.
Granite Tower Building
222 N. 32nd St., Suite 700
P.O. Box 31318
Billings, MT 59117-1318
(406) 656-6399 FAX (406) 656-6398

SS2

Sheet No. 23

OGEE CREST LAYOUT TABLES

SPILLWAY FLOOR PROFILE

SURVEINER STATION	TOP OF FLOOR ELEVATION	COMMENTS
+1+10	5314.40	JOINT
+1+25	5313.35	JOINT
+1+50	5311.60	JOINT
+1+60	5310.90	BEGIN V.C.#1
+1+62	5310.74	
+1+64	5310.52	
+1+65	5310.26	
+1+68	5309.94	
+1+70	5309.60	END V.C.#1
+1+75	5308.75	JOINT
+2+00	5304.50	JOINT
+2+25	5300.25	JOINT
+2+50	5296.00	JOINT
+2+75	5291.75	JOINT
+3+00	5287.50	JOINT
+3+10	5285.80	BEGIN V.C.#2
+3+15	5284.90	
+3+20	5283.92	
+3+25	5282.84	JOINT
+3+30	5281.67	
+3+35	5280.40	
+3+40	5278.05	
+3+45	5277.60	
+3+50	5276.07	
+3+55	5274.44	
+3+60	5272.72	
+3+65	5270.90	
+3+70	5269.00	END V.C.#2
+3+75	5267.00	JOINT
+4+00	5257.00	JOINT
+4+25	5247.00	JOINT
+4+50	5237.00	JOINT
+4+60	5233.50	JOINT
+4+65	5233.00	JOINT
+5+00	5233.00	JOINT
+5+15	5233.00	
+5+24	5236.00	
+5+25	5236.00	END BASIN

PROFILE ALONG CENTERLINE


CENTERLINE STATION	TOP OF FLOOR ELEVATION
+075.00	5324.17
+075.50	5324.81
+076.00	5324.84
+076.50	5324.90
+077.18	5325.00
+077.50	5324.99
+078.00	5324.94
+078.50	5324.86
+079.00	5324.76
+079.50	5324.62
+080.00	5324.46
+080.50	5324.27
+081.00	5324.05
+081.50	5323.81
+082.00	5323.54
+082.50	5323.25
+083.00	5322.94
+084.00	5322.23
+086.00	5320.59
+088.00	5319.70
+090.00	5318.67
+092.00	5317.77
+094.00	5317.00
+096.00	5316.34
+098.00	5315.80
+100.00	5315.37
+105.00	5314.75
+110.00	5314.40

PROFILE ALONG
INSIDE FACE OF WALL



CENTERLINE STATION	OFFSET FROM CENTERLINE		WALL THICKNESS	TOP OF FLOOR ELEVATION
	Feet	Inches		
+0+00	28.00	28'-0"	+0+00	5324.17
+0+01	27.59	27'-6"	+0+00	5324.99
+0+02	27.20	27'-2 1/4"	+0+01	5324.99
+0+04	26.84	26'-10 1/4"	+0+10	5324.94
+0+31	26.40	26'-5 1/4"	+0+02	5324.08
+0+60	26.17	26'-2"	+0+20	5324.08
+0+09	25.87	25'-10 1/4"	+0+30	5324.92
+0+21	25.60	25'-7 1/4"	+0+30	5324.82
+0+25	25.35	25'-4 1/4"	+0+40	5324.86
+0+39	25.13	25'-1 1/4"	+0+50	5324.85
+0+43	24.95	24'-11 1/4"	+0+50	5324.16
+0+46	24.78	24'-9 1/4"	+0+50	5323.79
+0+53	24.65	24'-7 1/4"	+0+60	5323.37
+0+58	24.39	24'-4 1/4"	+0+70	5322.49
+0+66	24.13	24'-1 1/4"	+0+80	5321.52
+0+71	23.89	23'-10 1/4"	+0+90	5320.52
+0+88	23.65	23'-7 1/4"	+1+00	5319.78
+0+96	23.42	23'-5"	+1+01	5319.02
+1+00	23.19	23'-2 1/4"	+1+02	5318.31
+1+01	22.96	22'-9 1/4"	+1+03	5317.89
+1+02	22.77	22'-6 1/4"	+1+04	5317.12
+1+03	22.56	22'-3 1/4"	+1+05	5316.64
+1+04	22.37	22'-4 1/4"	+1+06	5316.13
+1+06	22.01	22'-0 1/4"	+1+08	5316.23
+1+08	21.67	21'-8 1/4"	+1+10	5314.65
+1+10	21.44	21'-5 1/4"	+1+11	5314.40

OGEE CREST CURVED SLOPE LAYOUT BY CONTOUR



TOP OF FLOOR ELEVATION	RADIUS POINT AT STATION	RADIUS	
		Feet	Feet-Inches
5325.00	1+08.63	31.45	31'-5 1/2"
5324.00	1+11.50	30.37	30'-4 3/8"
5323.00	1+13.52	30.59	30'-7"
5322.00	1+15.05	30.89	30'-8 3/4"
5321.00	1+16.74	30.89	30'-10 1/8"
5320.00	1+18.89	31.20	31'-2 1/2"
5319.00	1+21.07	31.72	31'-8 5/8"
5318.00	1+24.03	32.55	32'-6 1/2"
5317.00	1+27.65	33.63	33'-7 1/2"
5316.00	1+33.99	38.74	38'-8 3/8"
5315.00	1+53.97	51.59	51'-7 1/2"

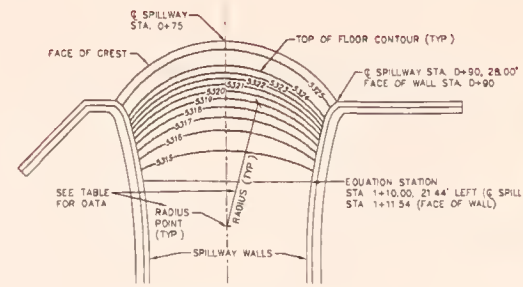


OGEE CREST PLAN

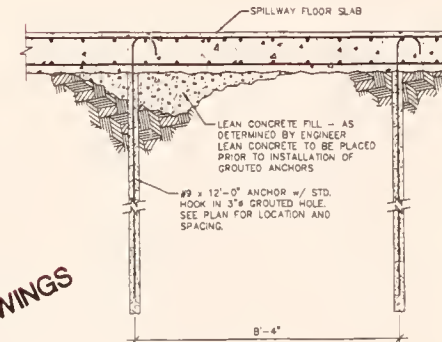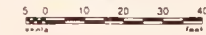

C **DETAIL**
SS3 **FLOOR SLAB ANCHOR**

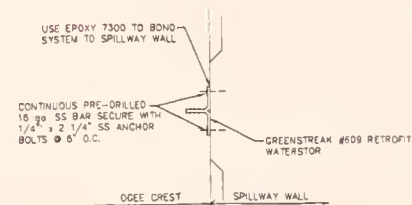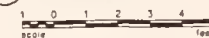

D SECTION
SS3 TYPICAL WATERSTOP AT INTERSECTION
OF OGEE CREST AND SPILLWAY WALL

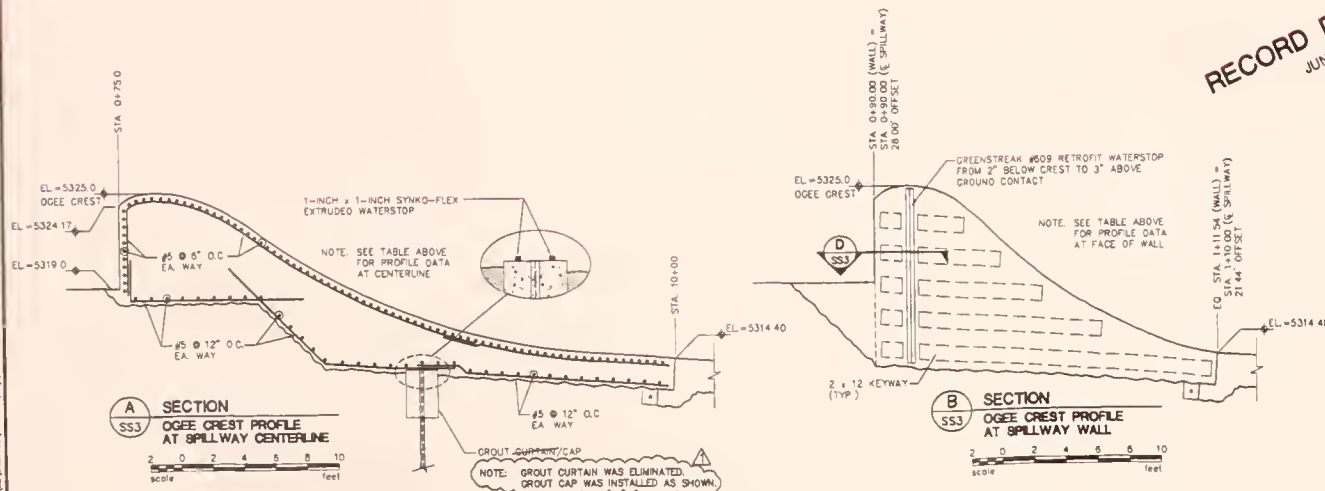

RECORD DRAWINGS
JUNE 2003

● Project No. BMOB7163 ● S-SPLWY OMC ● Date FEB 2002 ● Designed CRS ● Drawn GAE ● Checked CRS ● Approved JAT

BART DAM REHABILITATION - PHASE II
MEAGHER COUNTY, MONTANA


CLYDE R
SMITH
10622 PFE
PROFESSIONAL ENGINEER
E. O. TAYLOR
6-6398

HKMA Engineering Inc.
Granite Tower Building
222 N. 32nd St., Suite 700
P.O. Box 31318
Billings, MT 59107-1318
(406) 656-6399 FAX (406) 656-6398




Sheet No.
SS3
of 23



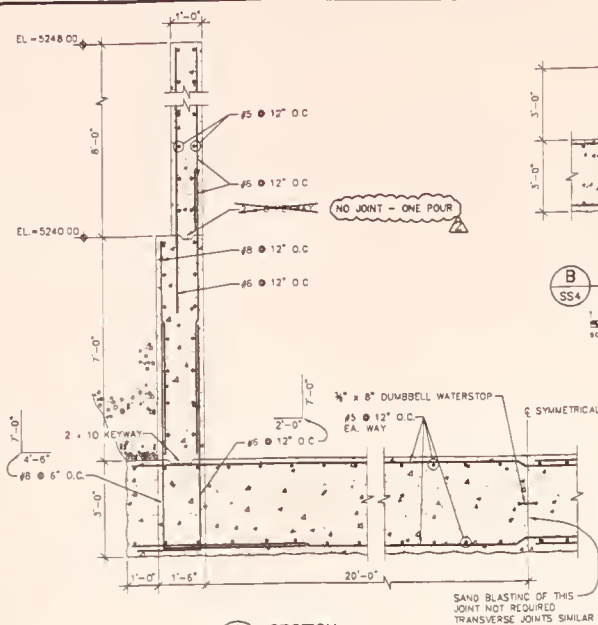


A SECTION
SS4
STILLING BASIN WALL
SCALE 1 0 1 2 3 4 5
feet

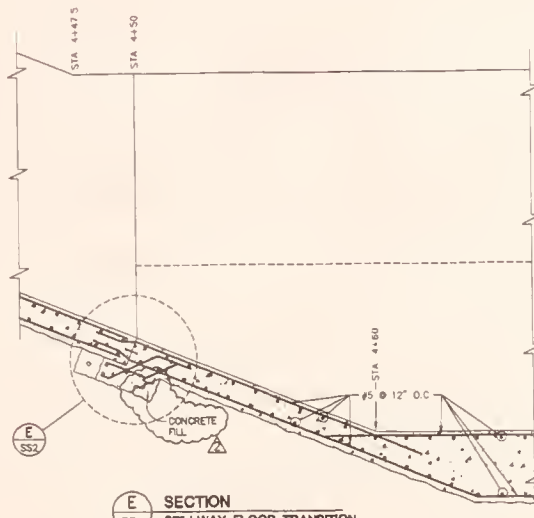


E SECTION
SS4
SPILLWAY FLOOR TRANSITION
SCALE 1 0 1 2 3 4 5 6 7
feet

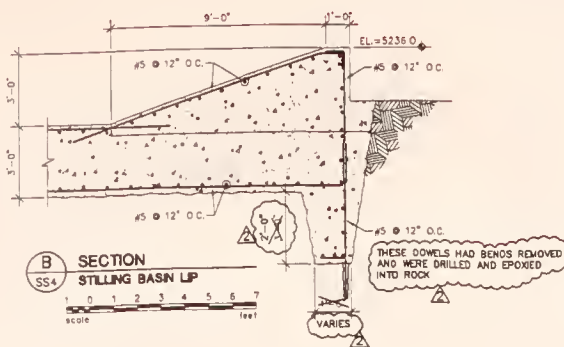


B SECTION
SS4
STILLING BASIN LIP
SCALE 1 0 1 2 3 4 5 6 7
feet

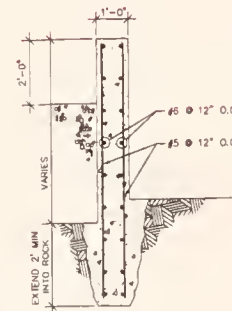

C SECTION
SS4
STILLING BASIN WINGWALL
SCALE 1 0 1 2 3 4 5
feet

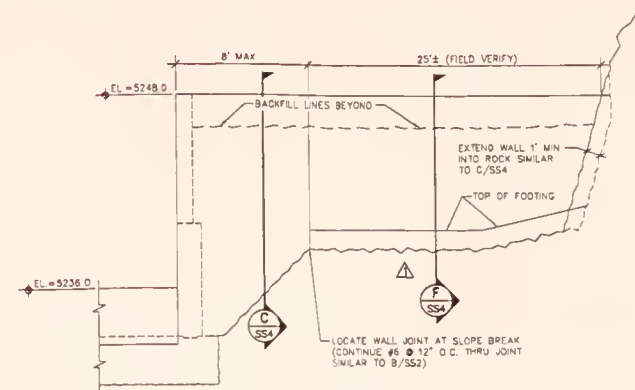

D ELEVATION
SS4
STILLING BASIN WINGWALL
SCALE 2 0 2 4 6 8 10
feet

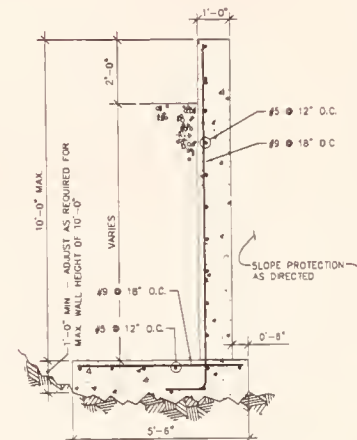

F SECTION
SS4
STILLING BASIN WINGWALL
SCALE 1 0 1 2 3 4 5
feet

RECORD DRAWINGS
JUNE 2003

Project No.	Revision	By	Date
BA007163	1	CS	10/19/02


BAR DAM REHABILITATION - PHASE II
MEAGHER COUNTY, MONTANA
PRINCIPAL SPILLWAY STRUCTURE
STILLING BASIN DETAILS




HKA Engineering Inc.
Granite Tower Building
222 N. 32nd St., Suite 700
P.O. Box 31318
Billings, MT 59107-1318
(406) 656-6399, FAX (406) 656-6398



Sheet No.
SS4
of 23

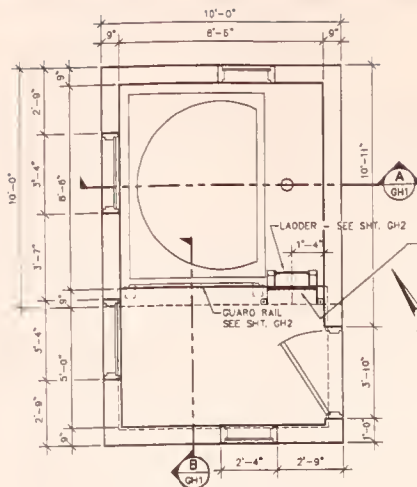


PLAN
GATE HOUSE

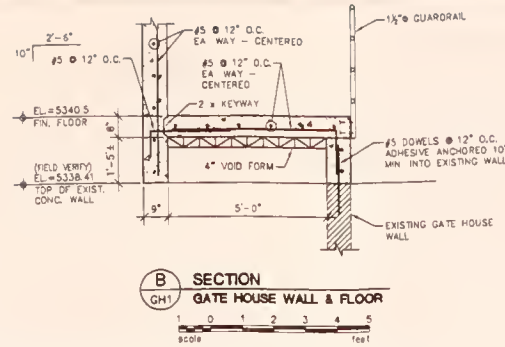

B SECTION
GATE HOUSE WALL & FLOOR


GENERAL NOTES

- APPLICABLE SPECIFICATIONS AND CODES
CONSTRUCTION AND DESIGN SHALL BE IN ACCORDANCE WITH THE UNIFORM BUILDING CODE (UBC), 1997 EDITION, AND WITH THE LATEST EDITION OF THE APPLICABLE SPECIFICATIONS AND THE REQUIREMENTS NOTED AS FOLLOWS.
- DESIGN LOADS
a. DESIGN LOADS AND LOAD APPLICATIONS ARE IN ACCORDANCE WITH UBC
b. UNIFORM FLOOR LIVE LOADS 100 PSF
c. ROOF LOADS 30 PSF
d. WIND LOADS
1. BASIC WIND SPEED (60 YEAR) 80 MPH
2. EXPOSURE CATEGORY D
3. IMPORTANCE FACTOR 1.0
e. SEISMIC LOADS
1. SEISMIC ZONE ZONE 1, Z = 0.75
2. IMPORTANCE FACTOR 1.0
- CONSTRUCTION LOADS
STRUCTURES HAVE BEEN DESIGNED FOR DEAD LOADS AND THE DESIGN LOADS NOTED ABOVE. PROVIDE TEMPORARY BRACING, SHORING OR OTHER SUPPLEMENTAL SUPPORT DURING CONSTRUCTION AS NECESSARY TO PROTECT THE STRUCTURES FROM EXCESSIVE CONSTRUCTION LOADS.
- STEEL DECK
a. STEEL DECK SHALL CONFORM TO THE APPLICABLE SPECIFICATIONS FOR COMPOSITE DECKS, FORM DECKS AND ROOF DECKS OF THE STEEL DECK INSTITUTE
b. SCREW ROOF DECK TO SUPPORTING STEEL FRAMING AS NOTED IN SECTION

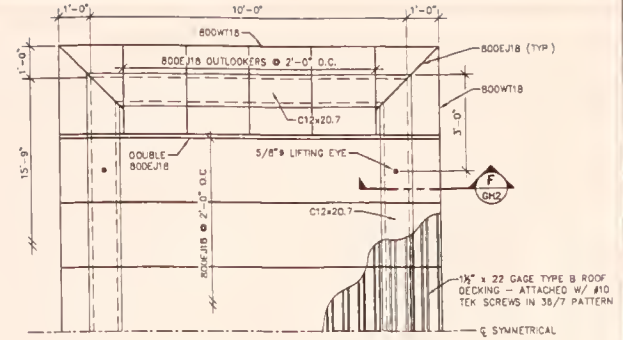


PLAN
GATE HOUSE ROOF FRAMING


RECORD DRAWINGS
JUNE 2003

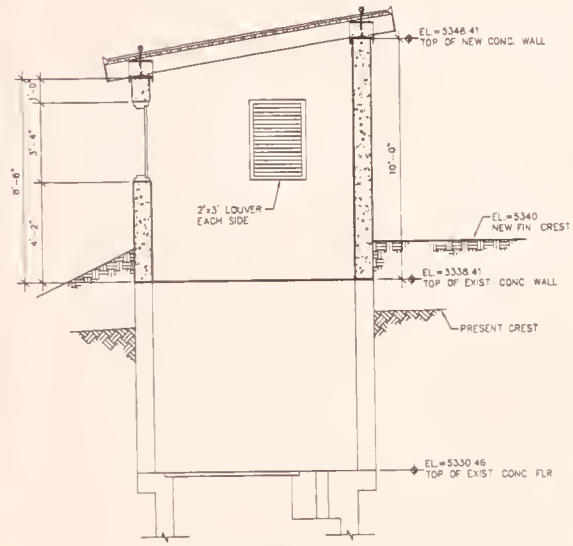

A SECTION
GATE HOUSE

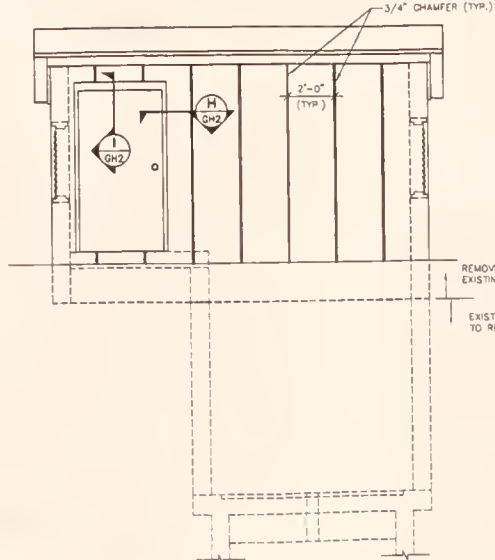

ELEVATION
GATE HOUSE

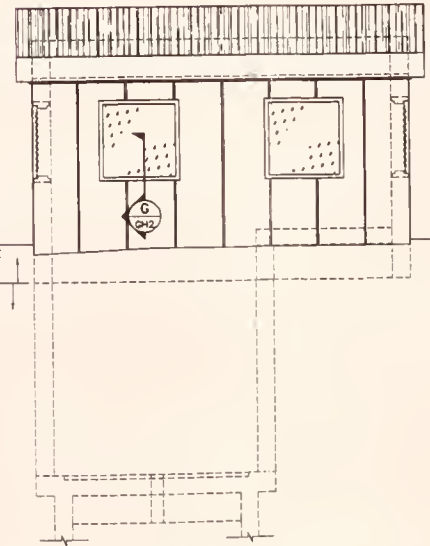

ELEVATION
GATE HOUSE

Project No. 040827-03 • Title: Dwg. • Date: FEB. 2002 • Designed: CRS • Drawn: CAC • Checked: CRS • Approved: JAT

BAR DAM REHABILITATION - PHASE II
MEAGER COUNTY, MONTANA

GATE HOUSE REPLACEMENT
PLAN, ELEVATIONS, SECTIONS AND DETAILS

No.	Revision	By	Date
1	1	JAT	6/03

WARNING
THIS DRAWING IS NOT BE LOANED, REPRODUCED, COPIED, OR IN ANY MANNER NOTED TO SCALE.

HCM Engineering Inc.
Granite Tower Building
222 N. 32nd St., Suite 700
P.O. Box 31318
Billings, MT 59107-1318
(406) 656-6399 FAX (406) 656-6398



HCM ENGINEERING

Sheet No.
GH1
of 23







Q:\V\W\W\7163\Phase 2\W\W\7163\DWG\10717\2003 02 08 38 PM.MXD

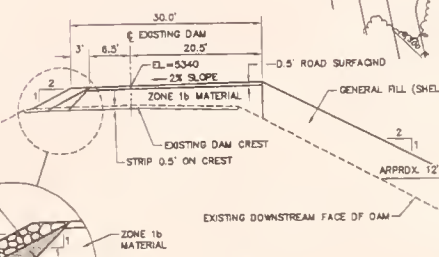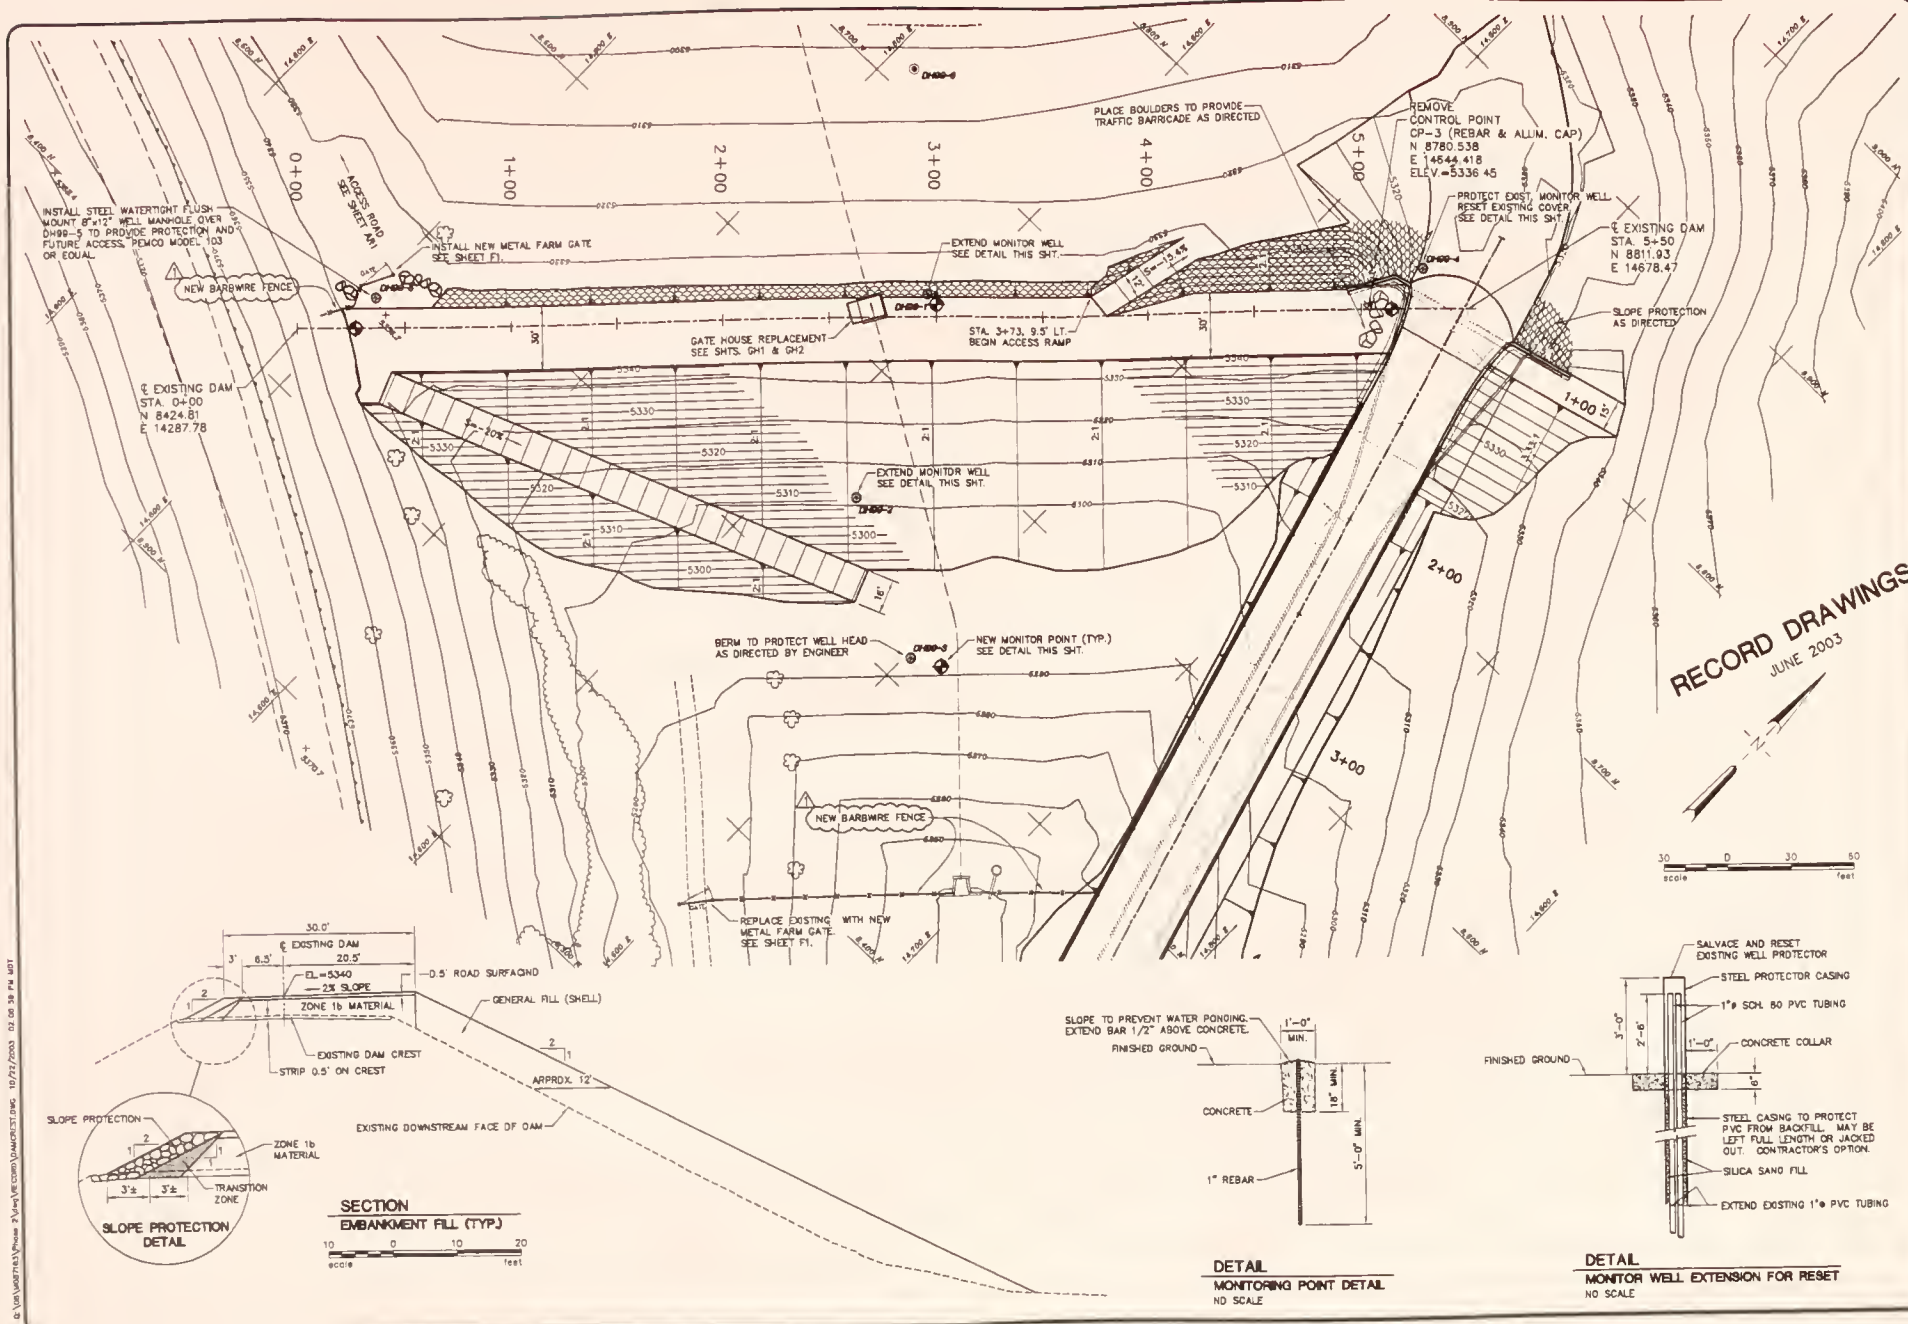

SECTION
EMBANKMENT FILL (TYP.)

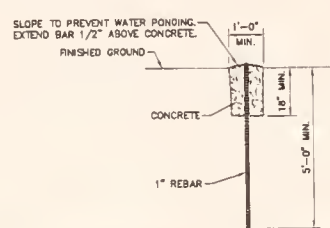

DETAIL
MONITORING POINT DETAIL
NO SCALE

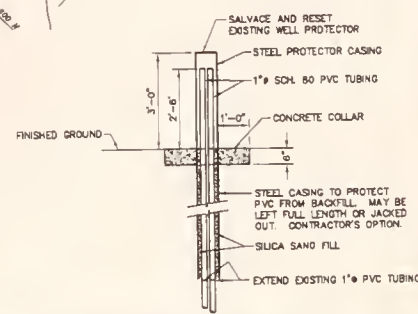

DETAIL
MONITOR WELL EXTENSION FOR RESET
NO SCALE

RECORD DRAWINGS
JUNE 2003

Project No. 80087163 • DAMCWS1.DWG • Date: FEB. 2002 • Designed: JNT • Checked: JNT • Approved: JNT

Revision By Date

No.	Revision	By	Date
1	Record	JNT	6/03

WARNING

THIS DRAWING IS NOT TO SCALE

BAR DAM REHABILITATION - PHASE II

MEAGHER COUNTY, MONTANA

EMBANKMENT ENLARGEMENT PLAN



HKA Engineering Inc.
Granite Tower Building
222 N. 32nd St., Suite 700
P.O. Box 31318
Billings, MT 59107-1318
(406) 656-6399, FAX (406) 656-6398

Sheet No.

E1

of 23



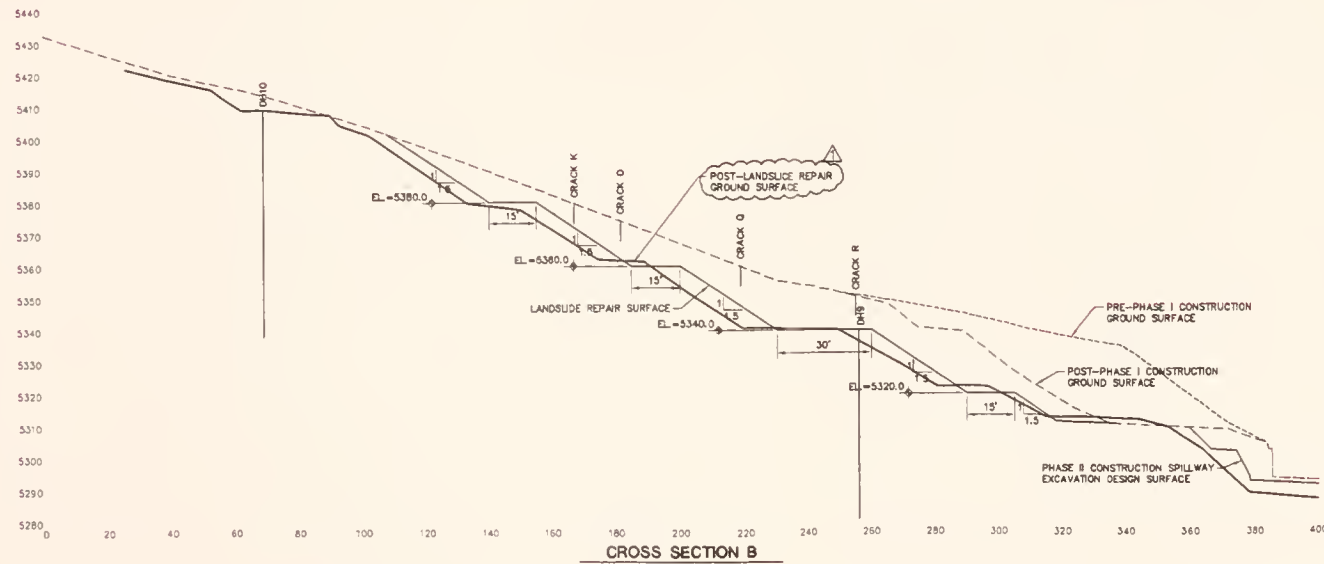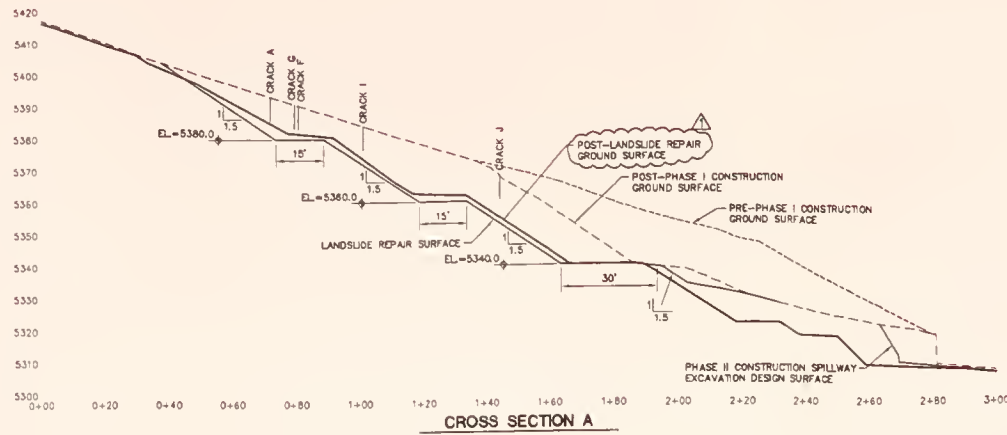

RECORD DRAWINGS
JUNE 2003

No.	Revision	By	Date	Checked	Appr.	Drawn	Scale	Sheet	Of
1									

Project No. 04037153 • LSR/PAIR DMC • Date: June 2002 • Designed: SR • Drawn: CAE • Checked: JAT • Approved: JAT

BAR DAM REHABILITATION - LANDSLIDE REPAIR
MEAGHER COUNTY, MONTANA
LANDSLIDE AREA
CROSS SECTIONS A and B


Sheet No.
LR2
of 3

of 3

HCM Engineering Inc.
Granite Tower Building
222 N. 32nd St., Suite 700
P.O. Box 31318
Billings, MT 59107-1318
(406) 656-6399, FAX (406) 656-6398

HCM
ENGINEERING



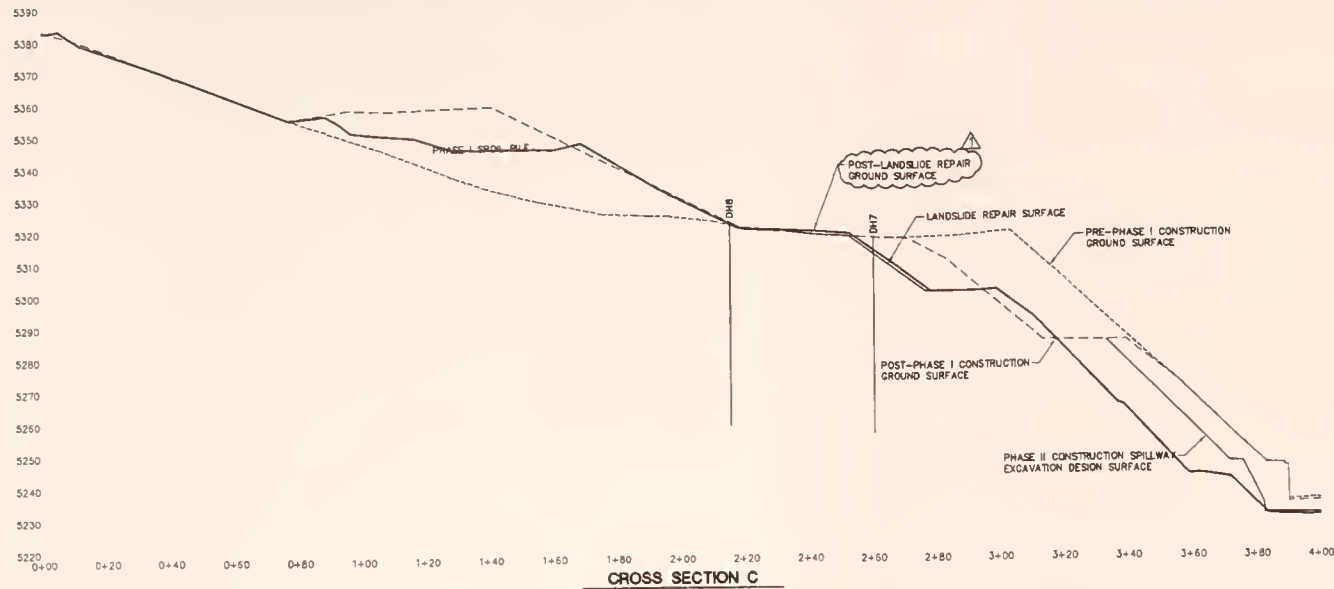

RECORD DRAWINGS
JUNE 2003

• Project No. BMD07163 • LUNEFAR DMC • Date JUNE 2007 • Desired SE • Drawn GAF • Checked JHT • Approved JHT

BAR DAM REHABILITATION - LANDSLIDE REPAIR
MEAGHER COUNTY, MONTANA

LANDSLIDE AREA
CROSS SECTION C

No.	Revision	By	Date
1	A	JHT	6/03

WARNING
DO NOT SCALE DRAWING
FOR CONSTRUCTION

HCM Engineering Inc.
Granite Tower Building
222 N. 32nd St., Suite 700
P.O. Box 31318
Billings, MT 59107-1318
(406) 656-6399, FAX (406) 656-6398

Sheet No
LR3
of 3

